SUFA AT PUBLIC SCHOOLS IN SOUTH LEBANON

FINAL DESIGN

JULY 2023

PROJECT MAIN PARTICIPANTS

german cooperation
DEUTSCHE ZUSAMMENARBEIT

giz Deutsche Gesellschaft für Internationale Zusammenarbeit (GIZ) GmbH

الجمهورية اللبنانية
وزارة التربية والتعليم العالي

CLIENT

LCEC
LEBANESE CENTER FOR ENERGY CONSERVATION
المركز اللبناني لحفظ الطاقة
efficient resources, sustainable achievements

CONSULTANT

INTERNATIONAL CONSULTANT - ICON

iCON INTERNATIONAL CONSULTANT

Beirut- Lebanon
P.O.BOX701, Antelias
Tel : + 961 4 404304 / 5
Fax : + 961 4 414250
e-mail: info@icon-py.com
Website: www.icon-py.com

INDEX TO DRAWINGS

NUMBER	DRAWING TITLE
000-A-001	SUFA SOUTH SHOOLS - COVER PAGE
000-A-002	SUFA SOUTH SHOOLS - LIST OF DRAWINGS
001-A-000	DEIR QANOUN RAS AL AIN INTERMEDIATE PUBLIC SCHOOL | TYR - AS BUILT PLAN
001-A-101	DEIR QANOUN RAS AL AIN INTERMEDIATE PUBLIC SCHOOL | TYR - PLAN
001-A-201	DEIR QANOUN RAS AL AIN INTERMEDIATE PUBLIC SCHOOL | TYR - OUTDOOR CLASSROOM PROTOTYPE 2 - DETAILS
002-A-000	KAFRA ELEMENTARY PUBLIC SCHOOL BINT JBEIL - AS BUILT PLAN
002-A-101	KAFRA ELEMENTARY PUBLIC SCHOOL BINT JBEIL - PLAN
002-A-201	KAFRA ELEMENTARY PU BLIC SCHOOL BINT JBEIL - OUTDOOR CLASSROOM PROTOTYPE 2 - DETAILS
003-A-000	MATARIET EL CHOUMAR INTERMEDIATE PUBLIC SCHOOL - AS BUILT PLAN
003-A-101	MATARIET EL CHOUMAR INTERMEDIATE PUBLIC SCHOOL - PLAN
003-A-201	MATARIET EL CHOUMAR INTERMEDIATE PUBLIC SCHOOL - OUTDOOR CLASSROOM PROTOTYPE 1 - DETAILS
003-A-202	MATARIET EL CHOUMAR INTERMEDIATE PUBLIC SCHOOL - CANOPY DETAILS
004-A-000	ZEBDINE INTERMEDIATE PUBLIC SCHOOL | NABATIEH - AS BUILT PLAN
004-A-101	ZEBDINE INTERMEDIATE PUBLIC SCHOOL | NABATIEH - PLAN
005-A-000	BAAKLIN MIXED INTERMEDIATE PUBLIC SCHOOL - AS BUILT PLAN
005-A-101	BAAKLIN MIXED INTERMEDIATE PUBLIC SCHOOL - PLAN
005-A-201	BAAKLIN MIXED INTERMEDIATE PUBLIC SCHOOL - OUTDOOR CLASSROOM PROTOTYPE 1 - DETAILS
005-A-202	BAAKLIN MIXED INTERMEDIATE PUBLIC SCHOOL - CANOPY DETAILS
006-A-501	MISCELLANEOUS DETAILS
006-A-502	MISCELLANEOUS DETAILS
006-A-503	MISCELLANEOUS DETAILS
006-A-504	MISCELLANEOUS DETAILS

GENERAL NOTES

1. UNLESS OTHERWISE NOTED, ALL DIMENSIONS ARE IN CENTIMETERS.
2. DO NOT SCALE DRAWINGS, DIMENSIONS GIVEN SHALL GOVERN.
3. CONTRACTOR SHALL SUBMIT SHOP DRAWINGS AND SAMPLES OF ALL MATERIALS & COLORS FOR CLIENT & ARCHITECT APPROVAL.
4. ALL DIMENSIONS MUST BE VERIFIED BY CONTRACTORS BEFORE PREPARATION OF SHOP DRAWINGS.
5. THE ARCHITECT MUST BE INFORMED ABOUT CONTRADICTION OF ANY KIND BEFORE CONSTRUCTION BEGINS.
6. THE CONTRACTOR SHOULD CHECK THE PLOT AND SCHOOL BUILDING SERVICES CONNECTION POINTS, IN PARTICULAR FOR THE RAINWATER HARVESTING TANKS BEFORE INSTALLATION.
7. THE CONTRACTOR SHOULD REFER TO ALL PROTOTYPES DOCUMENTS PROVIDED BY LCEC THAT MUST BE READ IN COORDINATION WITH THE ACRHITECTURAL DRAWINGS.

PROJECT MAIN PARTICIPANTS

german cooperation
DEUTSCHE ZUSAMMENARBEIT

giz Deutsche Gesellschaft für Internationale Zusammenarbeit (GIZ) GmbH

الجمهورية اللبنانية
وزارة التربية والتعليم العالي

CLIENT

LCEC
LEBANESE CENTER FOR ENERGY CONSERVATION
المركز اللبناني لحفظ الطاقة
efficient resources, sustainable achievements

CONSULTANT

INTERNATIONAL CONSULTANT - ICON

ICON INTERNATIONAL CONSULTANT
Beirut- Lebanon
P.O.BOX701, Antelias
Tel : + 961 4 404304 / 5
Fax : + 961 4 414250
e-mail: info@icon-py.com
Website: www.icon-py.com

Rev #	Last revision titles	Drawn by: dd/mm/yy	Verified by: dd/mm/yy	Approved by: dd/mm/yy	Status
01	Final Design	R.R 31/7/23	R.B 31/7/23	P.Y 31/7/23	X
00	Final Design	R.R 16/6/23	R.B 16/6/23	P.Y 18/6/23	X

Issuer internal approval circuit and revision history

Project: ------

SUFA AT PUBLIC SCHOOLS IN LEBANON

Project Work Package: ----------

Issuer: **ICON**

Phase / Nature: FD

FINAL DESIGN

Primary Technical Discipline: A – –

ARCHITECTURE

Drawing Number and Title: **A-002**

SUFA SOUTH SCHOOLS
LIST OF DRAWINGS

ARCHITECTURE
FINISH LEVELS -------

Revision Number: 01

Review Cycle :

Folio	Format	Scale
	A1	

File spec : ----------

341

337

337

337

337

281

281

281

282

336

TOPOGRAPHIC SURVEY PROVIDED BY " LCEC "

GENERAL NOTES

1. UNLESS OTHERWISE NOTED, ALL DIMENSIONS ARE IN CENTIMETERS.
2. DO NOT SCALE DRAWINGS, DIMENSIONS GIVEN SHALL GOVERN.
3. CONTRACTOR SHALL SUBMIT SHOP DRAWINGS AND SAMPLES OF ALL MATERIALS & COLORS FOR CLIENT & ARCHITECT APPROVAL.
4. ALL DIMENSIONS MUST BE VERIFIED BY CONTRACTORS BEFORE PREPARATION OF SHOP DRAWINGS.
5. THE ARCHITECT MUST BE INFORMED ABOUT CONTRADICTION OF ANY KIND BEFORE CONSTRUCTION BEGINS.
6. THE CONTRACTOR SHOULD CHECK THE PLOT AND SCHOOL BUILDING SERVICES CONNECTION POINTS, IN PARTICULAR FOR THE RAINWATER HARVESTING TANKS BEFORE INSTALLATION.
7. THE CONTRACTOR SHOULD REFER TO ALL PROTOTYPES DOCUMENTS PROVIDED BY LCEC THAT MUST BE READ IN COORDINATION WITH THE ACRHITECTURAL DRAWINGS.

PROJECT MAIN PARTICIPANTS

german cooperation
DEUTSCHE ZUSAMMENARBEIT

giz Deutsche Gesellschaft für Internationale Zusammenarbeit (GIZ) GmbH

الجمهورية اللبنانية
وزارة التربية والتعليم العالي

CLIENT

LCEC
LEBANESE CENTER FOR ENERGY CONSERVATION
المركز اللبناني لحفظ الطاقة
efficient resources, sustainable achievements

CONSULTANT

INTERNATIONAL CONSULTANT - ICON

ICON INTERNATIONAL CONSULTANT
Beirut- Lebanon
P.O.BOX701, Antelias
Tel : + 961 4 404304 / 5
Fax : + 961 4 414250
e-mail: info@icon-py.com
Website: www.icon-py.com

Rev #	Last revision titles	Drawn by: dd/mm/yy	Verified by: dd/mm/yy	Approved by: dd/mm/yy	Status
01	Final Design	R.R 31/7/23	R.B 31/7/23	P.Y 31/7/23	X
00	Final Design	R.R 16/6/23	R.B 16/6/23	P.Y 18/6/23	X

Issuer internal approval circuit and revision history

Project
SUFA AT PUBLIC SCHOOLS IN LEBANON

Project Work Package

Issuer
ICON

Phase / Nature: FD
FINAL DESIGN

Primary Technical Discipline: A--
ARCHITECTURE

Drawing Number and Title: A-000
DEIR QANOUN RAS AL AIN INTERMEDIATE PUBLIC SCHOOL AS BUILT PLAN
ARCHITECTURE
FINISH LEVELS -------

Revision Number: 01

Review Cycle :

Folio	Format	Scale
	A1	1/200

File spec : ----------

LEGEND:

OCP 02	OUTDOOR CLASSROOM PROTOTYPE 02
PM 01	KIDS PLAYGROUND MARKING
PM 02	PLAYGROUND MARKING BASKETBALL / FOOTBALL COURT
RH	RAIN WATER HARVESTING
CS	COMPOST STATION
RB	RECYCLE BIN
CB	CONCRETE BENCH
CP	CONCRETE POT
	PAVEMENT
	GREEN AREA
	INDOOR CO-CURRICULAR ACTIVITIES & RESERVATION FOR STORAGE

GENERAL NOTES

1. UNLESS OTHERWISE NOTED, ALL DIMENSIONS ARE IN CENTIMETERS.
2. DO NOT SCALE DRAWINGS, DIMENSIONS GIVEN SHALL GOVERN.
3. CONTRACTOR SHALL SUBMIT SHOP DRAWINGS AND SAMPLES OF ALL MATERIALS & COLORS FOR CLIENT & ARCHITECT APPROVAL.
4. ALL DIMENSIONS MUST BE VERIFIED BY CONTRACTORS BEFORE PREPARATION OF SHOP DRAWINGS.
5. THE ARCHITECT MUST BE INFORMED ABOUT CONTRADICTION OF ANY KIND BEFORE CONSTRUCTION BEGINS.
6. THE CONTRACTOR SHOULD CHECK THE PLOT AND SCHOOL BUILDING SERVICES CONNECTION POINTS, IN PARTICULAR FOR THE RAINWATER HARVESTING TANKS BEFORE INSTALLATION.
7. THE CONTRACTOR SHOULD REFER TO ALL PROTOTYPES DOCUMENTS PROVIDED BY LCEC THAT MUST BE READ IN COORDINATION WITH THE ACRHITECTURAL DRAWINGS.

PROJECT MAIN PARTICIPANTS

german cooperation
DEUTSCHE ZUSAMMENARBEIT

giz Deutsche Gesellschaft für Internationale Zusammenarbeit (GIZ) GmbH

الجمهورية اللبنانية
وزارة التربية والتعليم العالي

CLIENT

LCEC
LEBANESE CENTER FOR ENERGY CONSERVATION
المركز اللبناني لحفظ الطاقة
efficient resources, sustainable achievements

CONSULTANT

INTERNATIONAL CONSULTANT - ICON

ICON INTERNATIONAL CONSULTANT
Beirut- Lebanon
P.O.BOX701, Antelias
Tel : + 961 4 404304 / 5
Fax : + 961 4 414250
e-mail: info@icon-py.com
Website: www.icon-py.com

Rev #	Last revision titles	Drawn by: dd/mm/yy	Verified by: dd/mm/yy	Approved by: dd/mm/yy	Status
01	Final Design	R.R 31/7/23	R.B 31/7/23	P.Y 31/7/23	X
00	Final Design	R.R 16/6/23	R.B 16/6/23	P.Y 18/6/23	X

Issuer internal approval circuit and revision history

Project
SUFA AT PUBLIC SCHOOLS IN LEBANON

Project Work Package

Issuer
ICON

Phase / Nature: FD
FINAL DESIGN

Primary Technical Discipline: A – –
ARCHITECTURE

Drawing Number and Title: A-101
DEIR QANOUN RAS AL AIN INTERMEDIATE PUBLIC SCHOOL-PLAN

ARCHITECTURE
FINISH LEVELS -------

Revision Number: 01

Review Cycle :

Folio	Format	Scale
	A1	1/200

File spec : ----------

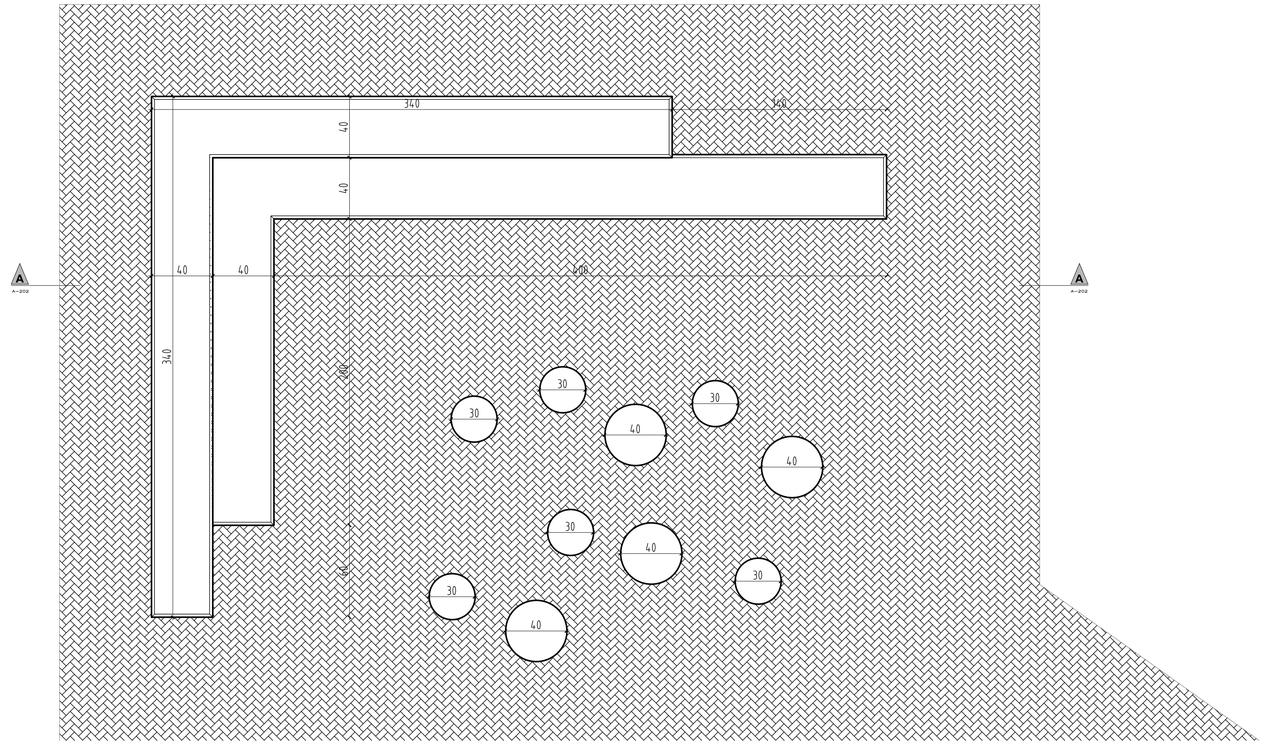

01 PLAN
A-201 SCALE: 1/120

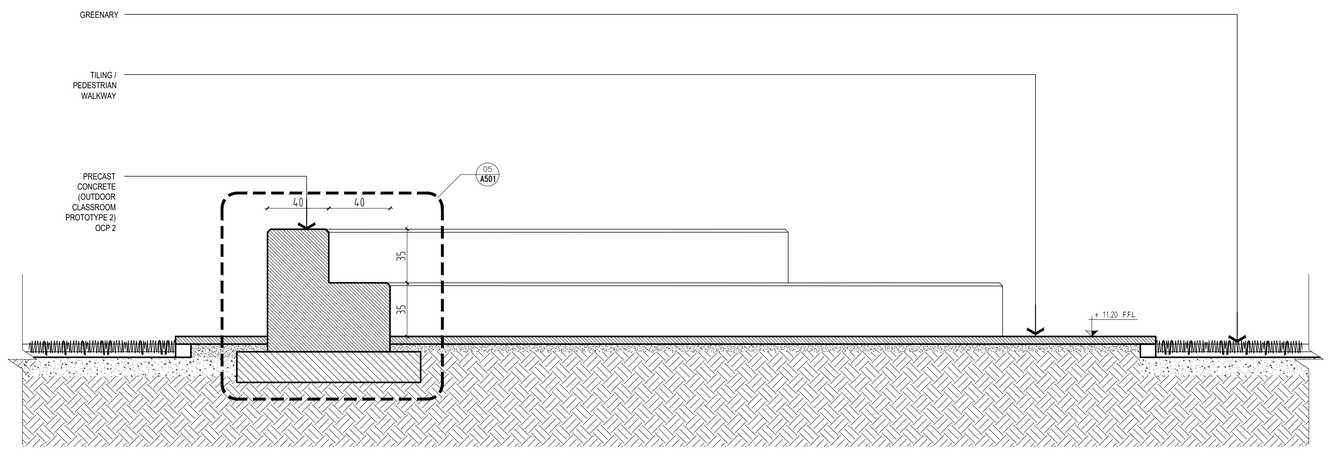

02 SECTION C-C
A-201 SCALE: 1/120

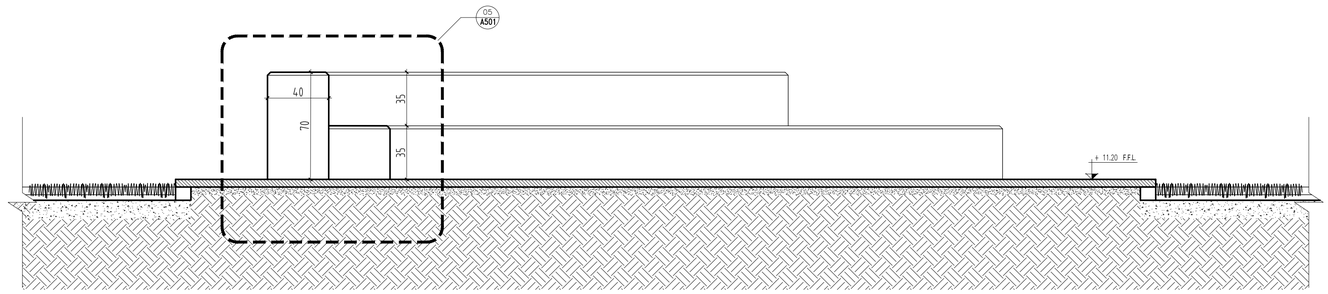

03 ELEVATION 01
A-201 SCALE: 1/120

GENERAL NOTES

1. UNLESS OTHERWISE NOTED, ALL DIMENSIONS ARE IN CENTIMETERS.
2. DO NOT SCALE DRAWINGS, DIMENSIONS GIVEN SHALL GOVERN.
3. CONTRACTOR SHALL SUBMIT SHOP DRAWINGS AND SAMPLES OF ALL MATERIALS & COLORS FOR CLIENT & ARCHITECT APPROVAL.
4. ALL DIMENSIONS MUST BE VERIFIED BY CONTRACTORS BEFORE PREPARATION OF SHOP DRAWINGS.
5. THE ARCHITECT MUST BE INFORMED ABOUT CONTRADICTION OF ANY KIND BEFORE CONSTRUCTION BEGINS.
6. THE CONTRACTOR SHOULD CHECK THE PLOT AND SCHOOL BUILDING SERVICES CONNECTION POINTS, IN PARTICULAR FOR THE RAINWATER HARVESTING TANKS BEFORE INSTALLATION.
7. THE CONTRACTOR SHOULD REFER TO ALL PROTOTYPES DOCUMENTS PROVIDED BY LCEC THAT MUST BE READ IN COORDINATION WITH THE ACRHITECTURAL DRAWINGS.

PROJECT MAIN PARTICIPANTS

german cooperation
DEUTSCHE ZUSAMMENARBEIT

giz Deutsche Gesellschaft für Internationale Zusammenarbeit (GIZ) GmbH

الجمهورية اللبنانية
وزارة التربية والتعليم العالي

CLIENT

LCEC
LEBANESE CENTER FOR ENERGY CONSERVATION
efficient resources, sustainable achievements

CONSULTANT

INTERNATIONAL CONSULTANT - ICON

Beirut- Lebanon
P.O.BOX701, Antelias
Tel : + 961 4 404304 / 5
Fax : + 961 4 414250
e-mail: info@icon-py.com
Website: www.icon-py.com

Rev #	Last revision titles	Drawn by: dd/mm/yy	Verified by: dd/mm/yy	Approved by: dd/mm/yy	Status
01	Final Design	R.R 31/7/23	R.B 31/7/23	P.Y 31/7/23	X
00	Final Design	R.R 16/6/23	R.B 16/6/23	P.Y 18/6/23	X

Issuer internal approval circuit and revision history

Project ------

SUFA AT PUBLIC SCHOOLS IN LEBANON

Project Work Package

Issuer

ICON

Phase / Nature FD

FINAL DESIGN

Primary Technical Discipline A--

ARCHITECTURE

Drawing Number and Title A-201

DEIR QANOUN RAS AL AIN INTERMEDIATE PUBLIC SCHOOL - OUTDOOR CLASSROOM PROTOTYPE 2 - DETAILS

ARCHITECTURE

FINISH LEVELS -------

Revision Number 01

Review Cycle :

Folio	Format	Scale
	A1	1/20

File spec : ----------

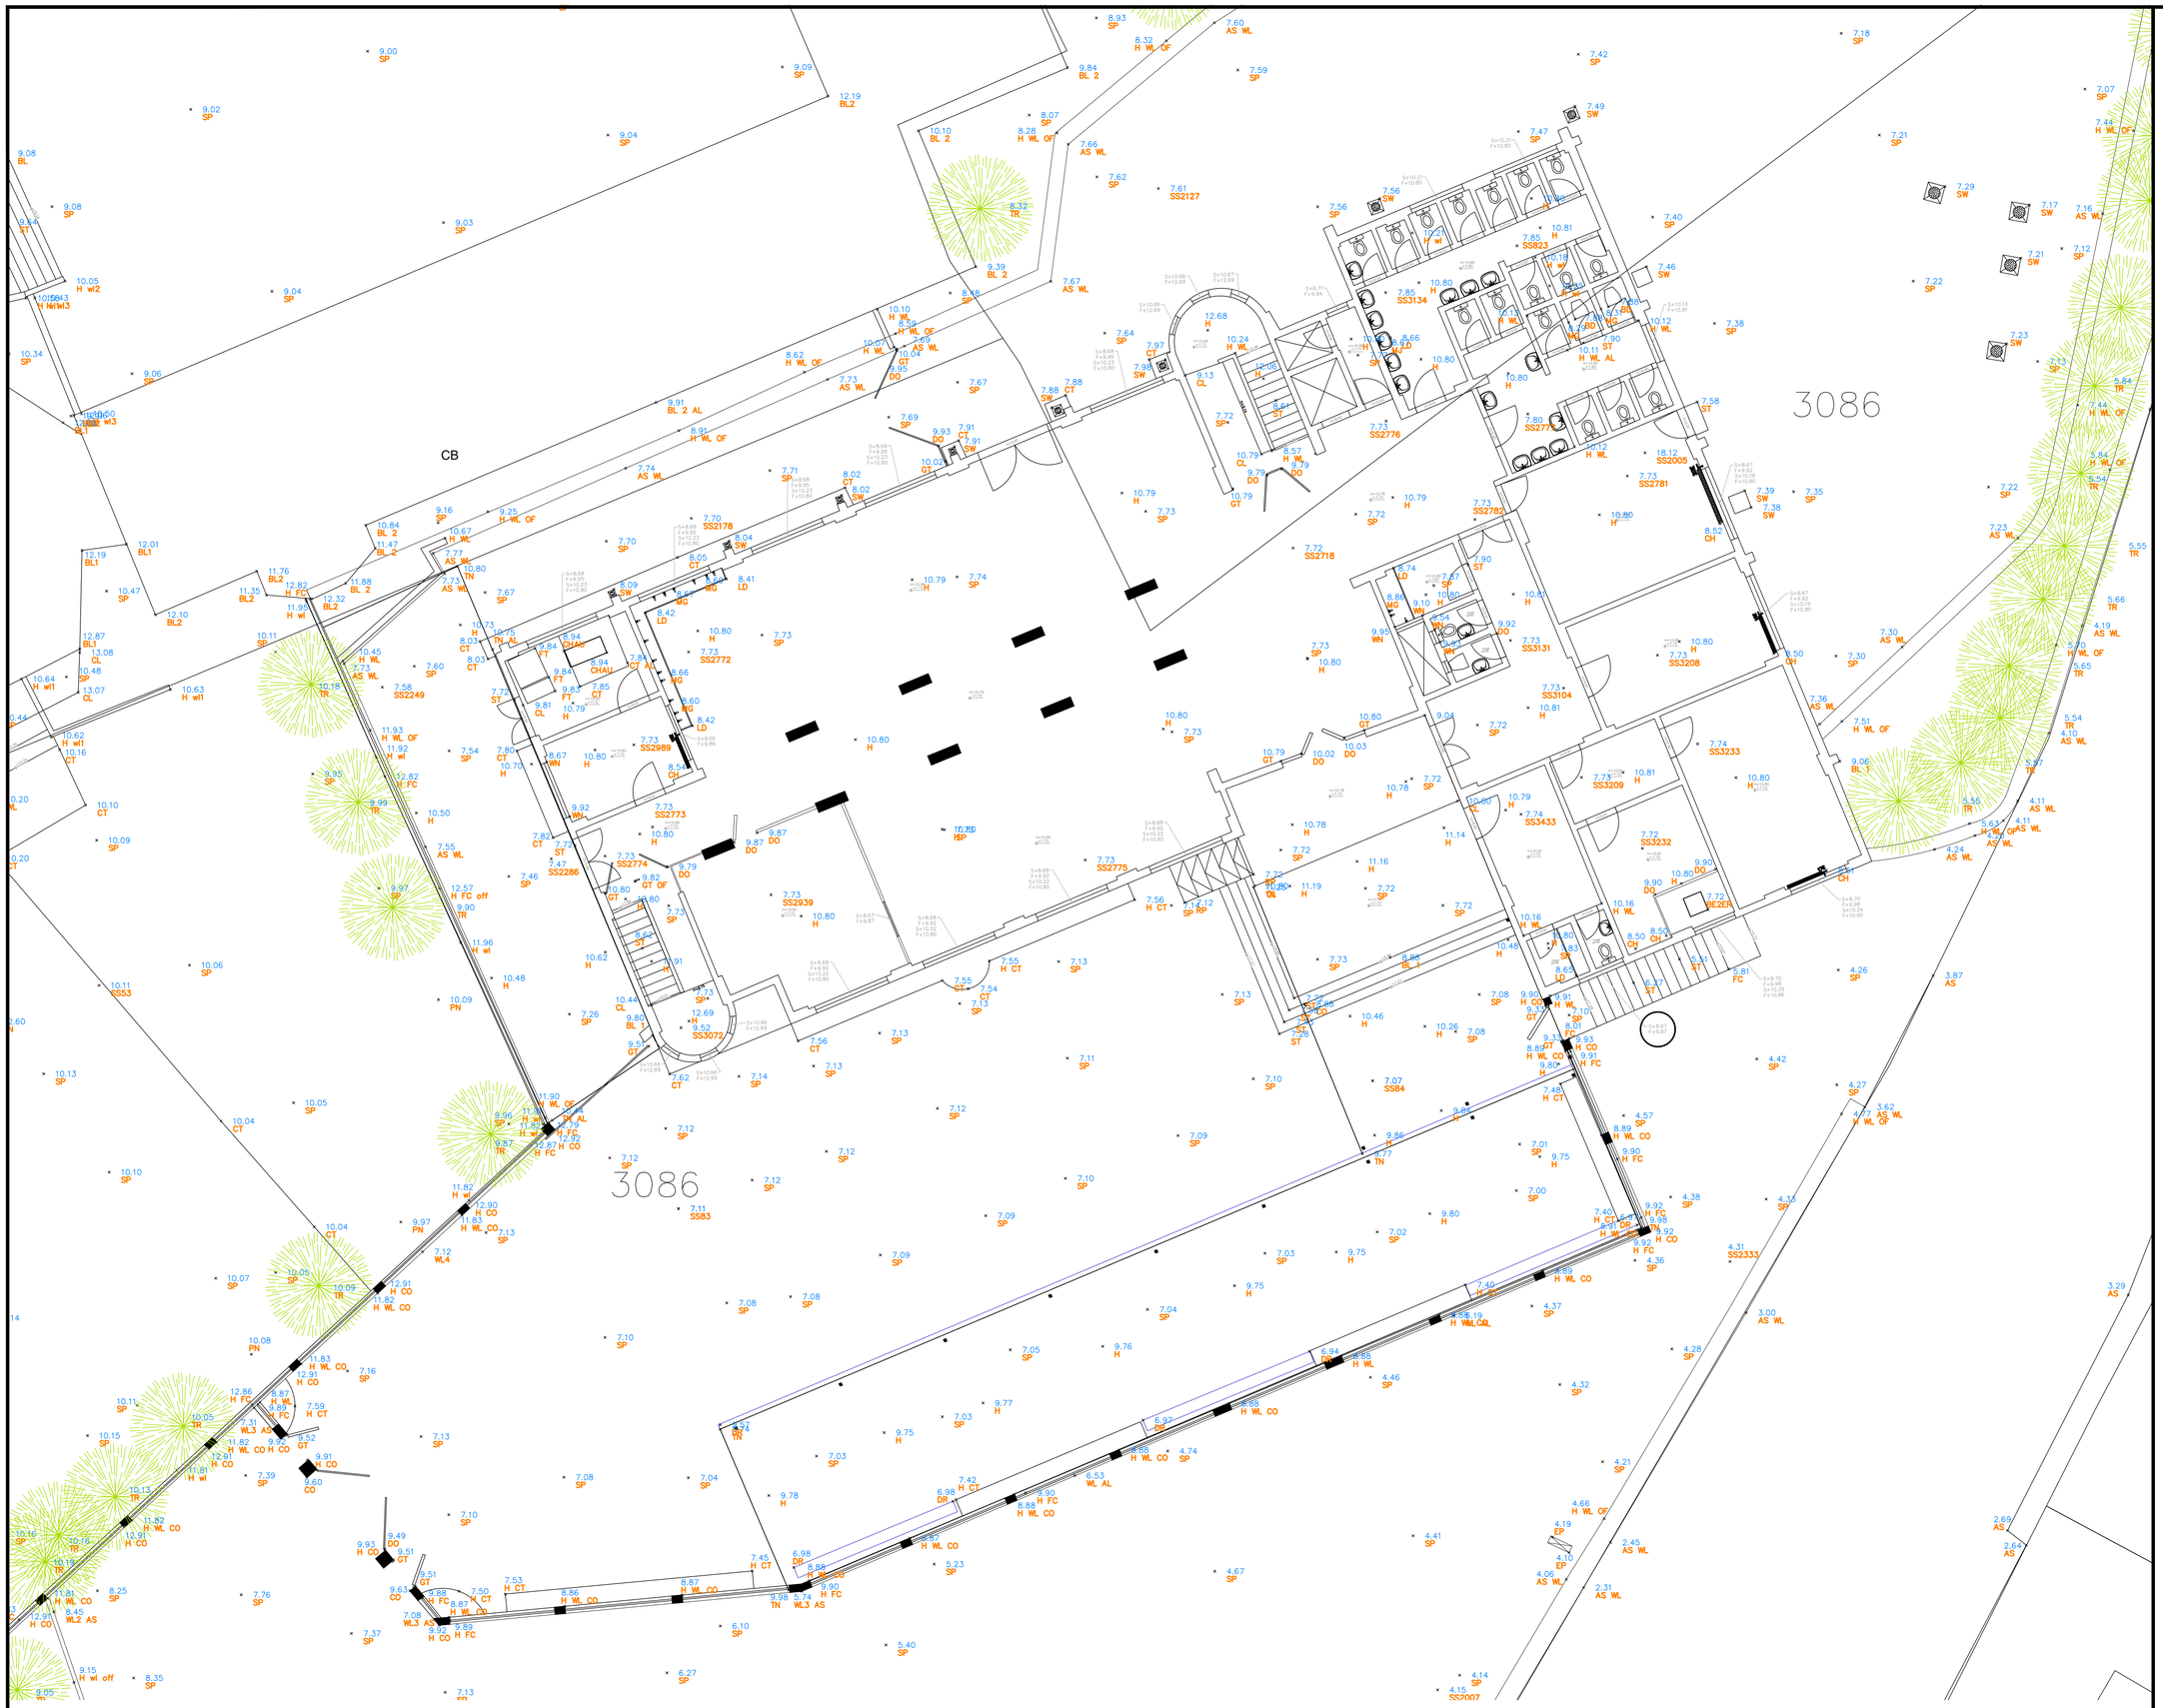

TOPOGRAPHIC SURVEY PROVIDED BY " LCEC "

GENERAL NOTES

1. UNLESS OTHERWISE NOTED, ALL DIMENSIONS ARE IN CENTIMETERS.
2. DO NOT SCALE DRAWINGS, DIMENSIONS GIVEN SHALL GOVERN.
3. CONTRACTOR SHALL SUBMIT SHOP DRAWINGS AND SAMPLES OF ALL MATERIALS & COLORS FOR CLIENT & ARCHITECT APPROVAL.
4. ALL DIMENSIONS MUST BE VERIFIED BY CONTRACTORS BEFORE PREPARATION OF SHOP DRAWINGS.
5. THE ARCHITECT MUST BE INFORMED ABOUT CONTRADICTION OF ANY KIND BEFORE CONSTRUCTION BEGINS.
6. THE CONTRACTOR SHOULD CHECK THE PLOT AND SCHOOL BUILDING SERVICES CONNECTION POINTS, IN PARTICULAR FOR THE RAINWATER HARVESTING TANKS BEFORE INSTALLATION.
7. THE CONTRACTOR SHOULD REFER TO ALL PROTOTYPES DOCUMENTS PROVIDED BY LCEC THAT MUST BE READ IN COORDINATION WITH THE ACRHITECTURAL DRAWINGS.

PROJECT MAIN PARTICIPANTS

german cooperation
DEUTSCHE ZUSAMMENARBEIT

giz Deutsche Gesellschaft für Internationale Zusammenarbeit (GIZ) GmbH

الجمهورية اللبنانية
وزارة التربية والتعليم العالي

CLIENT

LCEC
LEBANESE CENTER FOR ENERGY CONSERVATION
المركز اللبناني لدعم الطاقة
efficient resources, sustainable achievements

CONSULTANT

INTERNATIONAL CONSULTANT - ICON

ICON INTERNATIONAL CONSULTANT
Beirut- Lebanon
P.O.BOX701, Antelias
Tel : + 961 4 404304 / 5
Fax : + 961 4 414250
e-mail: info@icon-py.com
Website: www.icon-py.com

Rev #	Last revision titles	Drawn by: dd/mm/yy	Verified by: dd/mm/yy	Approved by: dd/mm/yy	Status
01	Final Design	R.R 31/7/23	R.B 31/7/23	P.Y 31/7/23	X
00	Final Design	R.R 16/6/23	R.B 16/6/23	P.Y 18/6/23	X

Issuer internal approval circuit and revision history

Project ------

SUFA AT PUBLIC SCHOOLS IN LEBANON

Project Work Package

Issuer

ICON

Phase / Nature FD

FINAL DESIGN

Primary Technical Discipline A--

ARCHITECTURE

Drawing Number and Title A-000

KAFRA ELEMENTARY PUBLIC SCHOOL
BINT JBEIL - AS BUILT PLAN

ARCHITECTURE

FINISH LEVELS --------

Revision Number 01

Review Cycle :

Folio	Format	Scale
	A1	1/100

File spec : ----------

LEGEND:

OCP 02	OUTDOOR CLASSROOM PROTOTYPE 02
PM 01	KIDS PLAYGROUND MARKING
PM 02	PLAYGROUND MARKING BASKETBALL / FOOTBALL COURT
RB	RECYCLE BIM
CB	CONCRETE BENCH
CP	CONCRETE POT
SC	STEEL CANOPY
	INDOOR CO-CURRICULAR ACTIVITIES & RESERVATION FOR STORAGE

GENERAL NOTES

1. UNLESS OTHERWISE NOTED, ALL DIMENSIONS ARE IN CENTIMETERS.
2. DO NOT SCALE DRAWINGS, DIMENSIONS GIVEN SHALL GOVERN.
3. CONTRACTOR SHALL SUBMIT SHOP DRAWINGS AND SAMPLES OF ALL MATERIALS & COLORS FOR CLIENT & ARCHITECT APPROVAL.
4. ALL DIMENSIONS MUST BE VERIFIED BY CONTRACTORS BEFORE PREPARATION OF SHOP DRAWINGS.
5. THE ARCHITECT MUST BE INFORMED ABOUT CONTRADICTION OF ANY KIND BEFORE CONSTRUCTION BEGINS.
6. THE CONTRACTOR SHOULD CHECK THE PLOT AND SCHOOL BUILDING SERVICES CONNECTION POINTS, IN PARTICULAR FOR THE RAINWATER HARVESTING TANKS BEFORE INSTALLATION.
7. THE CONTRACTOR SHOULD REFER TO ALL PROTOTYPES DOCUMENTS PROVIDED BY LCEC THAT MUST BE READ IN COORDINATION WITH THE ACRHITECTURAL DRAWINGS.

PROJECT MAIN PARTICIPANTS

german cooperation
DEUTSCHE ZUSAMMENARBEIT

giz Deutsche Gesellschaft für Internationale Zusammenarbeit (GIZ) GmbH

الجمهورية اللبنانية
وزارة التربية والتعليم العالي

CLIENT

LCEC
LEBANESE CENTER FOR ENERGY CONSERVATION
المركز اللبناني لحفظ الطاقة
efficient resources, sustainable achievements

CONSULTANT

INTERNATIONAL CONSULTANT - ICON

ICON INTERNATIONAL CONSULTANT
Beirut- Lebanon
P.O.BOX701, Antelias
Tel : + 961 4 404304 / 5
Fax : + 961 4 414250
e-mail: info@icon-py.com
Website: www.icon-py.com

Rev #	Last revision titles	Drawn by: dd/mm/yy	Verified by: dd/mm/yy	Approved by: dd/mm/yy	Status
01	Final Design	R.R 31/7/23	R.B 31/7/23	P.Y 31/7/23	X
00	Final Design	R.R 16/6/23	R.B 16/6/23	P.Y 18/6/23	X

Issuer internal approval circuit and revision history

Project
SUFA AT PUBLIC SCHOOLS IN LEBANON

Project Work Package

Issuer
ICON

Phase / Nature: FD
FINAL DESIGN

Primary Technical Discipline: A--
ARCHITECTURE

Drawing Number and Title: A-101

KAFRA ELEMENTARY PUBLIC SCHOOL
BINT JBEIL - PLAN

ARCHITECTURE
FINISH LEVELS -------

Revision Number: 01

Review Cycle :

Folio	Format	Scale
	A1	1/100

File spec : ----------

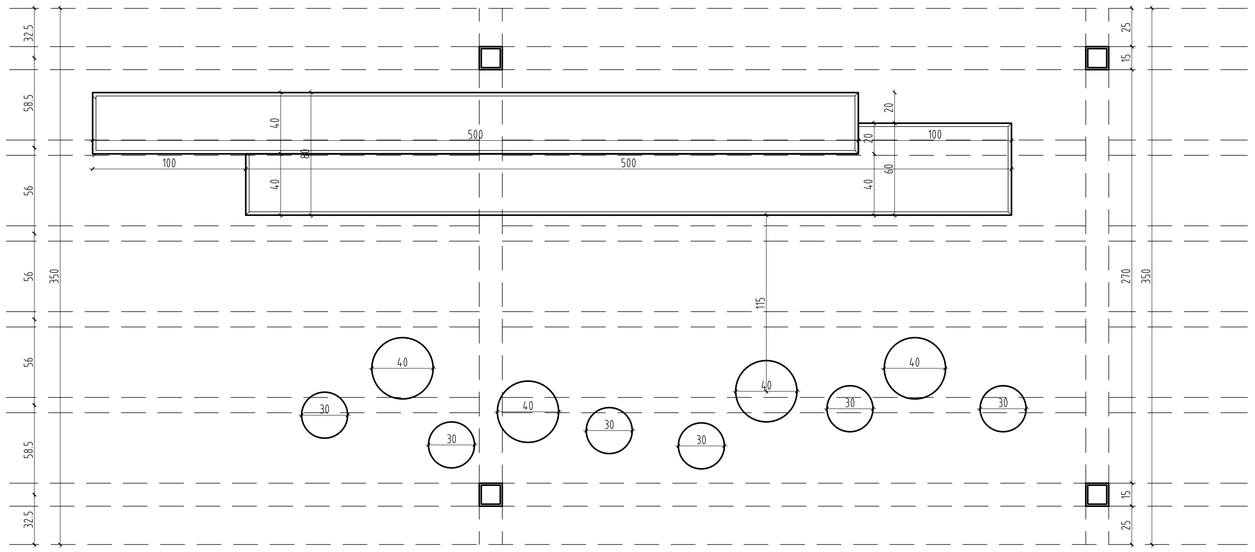

01 PLAN
A–201 SCALE: 1/120

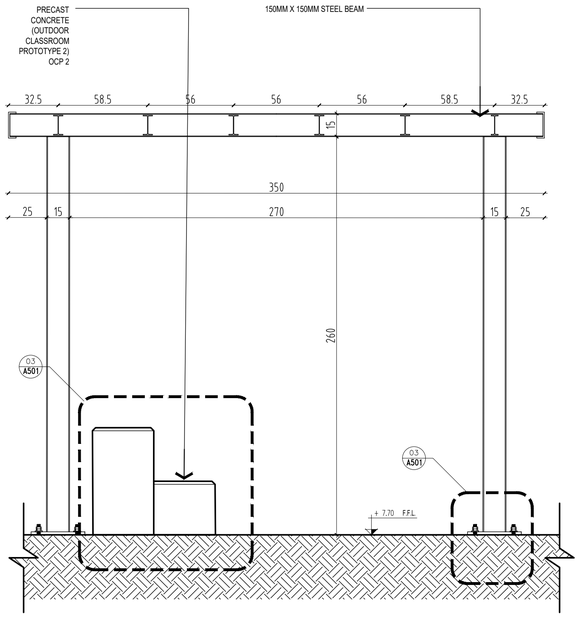

02 ELEVATION 01
A–201 SCALE: 1/120

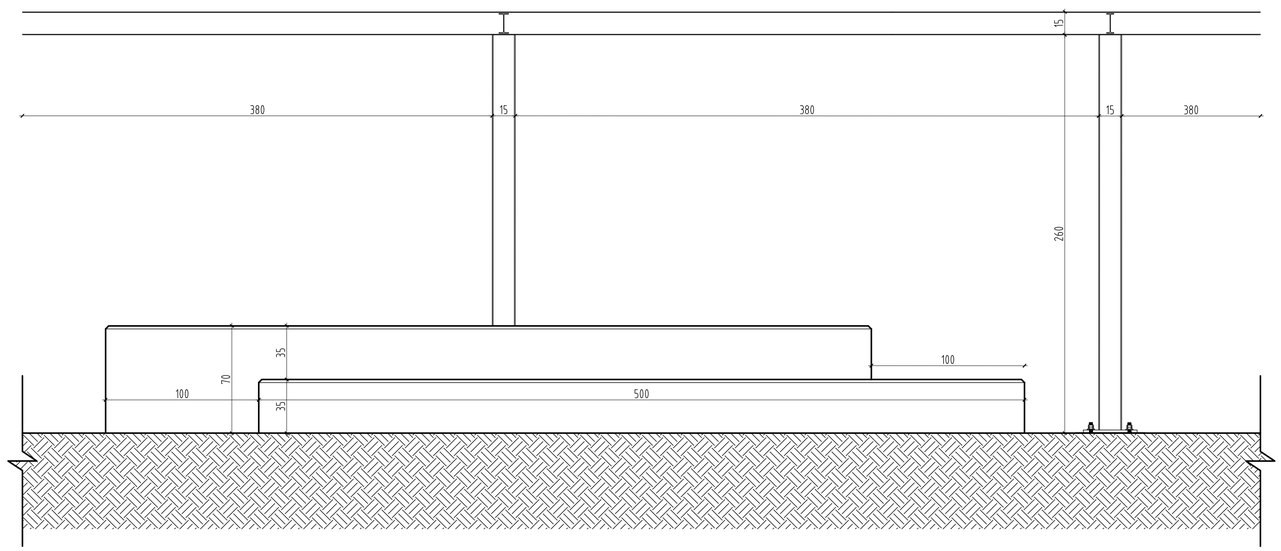

03 ELEVATION 02
A–201 SCALE: 1/120

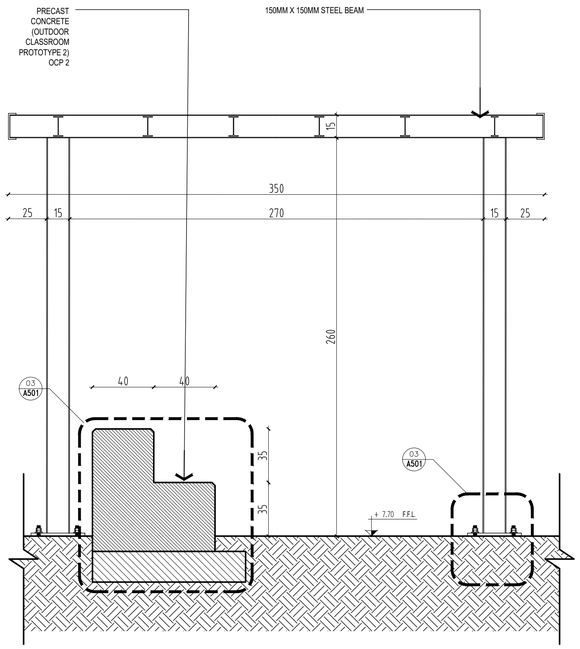

04 SECTION A-A
A–201 SCALE: 1/120

GENERAL NOTES

1. UNLESS OTHERWISE NOTED, ALL DIMENSIONS ARE IN CENTIMETERS.
2. DO NOT SCALE DRAWINGS, DIMENSIONS GIVEN SHALL GOVERN.
3. CONTRACTOR SHALL SUBMIT SHOP DRAWINGS AND SAMPLES OF ALL MATERIALS & COLORS FOR CLIENT & ARCHITECT APPROVAL.
4. ALL DIMENSIONS MUST BE VERIFIED BY CONTRACTORS BEFORE PREPARATION OF SHOP DRAWINGS.
5. THE ARCHITECT MUST BE INFORMED ABOUT CONTRADICTION OF ANY KIND BEFORE CONSTRUCTION BEGINS.
6. THE CONTRACTOR SHOULD CHECK THE PLOT AND SCHOOL BUILDING SERVICES CONNECTION POINTS, IN PARTICULAR FOR THE RAINWATER HARVESTING TANKS BEFORE INSTALLATION.
7. THE CONTRACTOR SHOULD REFER TO ALL PROTOTYPES DOCUMENTS PROVIDED BY LCEC THAT MUST BE READ IN COORDINATION WITH THE ACRHITECTURAL DRAWINGS.

PROJECT MAIN PARTICIPANTS

german cooperation
DEUTSCHE ZUSAMMENARBEIT

giz Deutsche Gesellschaft für Internationale Zusammenarbeit (GIZ) GmbH

الجمهورية اللبنانية
وزارة التربية والتعليم العالي

CLIENT

LCEC
LEBANESE CENTER FOR ENERGY CONSERVATION
المركز اللبناني لدعم الطاقة
efficient resources, sustainable achievements

CONSULTANT

INTERNATIONAL CONSULTANT - ICON

ICON INTERNATIONAL CONSULTANT
Beirut- Lebanon
P.O.BOX701, Antelias
Tel : + 961 4 404304 / 5
Fax : + 961 4 414250
e-mail: info@icon-py.com
Website: www.icon-py.com

Rev #	Last revision titles	Drawn by: dd/mm/yy	Verified by: dd/mm/yy	Approved by: dd/mm/yy	Status
01	Final Design	R.R 31/7/23	R.B 31/7/23	P.Y 31/7/23	X
00	Final Design	R.R 16/6/23	R.B 16/6/23	P.Y 18/6/23	X

Issuer internal approval circuit and revision history

Project
SUFA AT PUBLIC SCHOOLS IN LEBANON

Project Work Package

Issuer
ICON

Phase / Nature: FD
FINAL DESIGN

Primary Technical Discipline: A– –
ARCHITECTURE

Drawing Number and Title: A-101

KAFRA ELEMENTARY PUBLIC SCHOOL BINT JBEIL - OUTDOOR CLASSROOM PROTOTYPE 2 - DETAILS

ARCHITECTURE
FINISH LEVELS -------

Revision Number: 01

Review Cycle :

Folio	Format	Scale
	A1	1/20

File spec : ----------

TOPOGRAPHIC SURVEY PROVIDED BY " LCEC "

GENERAL NOTES

1. UNLESS OTHERWISE NOTED, ALL DIMENSIONS ARE IN CENTIMETERS.
2. DO NOT SCALE DRAWINGS, DIMENSIONS GIVEN SHALL GOVERN.
3. CONTRACTOR SHALL SUBMIT SHOP DRAWINGS AND SAMPLES OF ALL MATERIALS & COLORS FOR CLIENT & ARCHITECT APPROVAL.
4. ALL DIMENSIONS MUST BE VERIFIED BY CONTRACTORS BEFORE PREPARATION OF SHOP DRAWINGS.
5. THE ARCHITECT MUST BE INFORMED ABOUT CONTRADICTION OF ANY KIND BEFORE CONSTRUCTION BEGINS.
6. THE CONTRACTOR SHOULD CHECK THE PLOT AND SCHOOL BUILDING SERVICES CONNECTION POINTS, IN PARTICULAR FOR THE RAINWATER HARVESTING TANKS BEFORE INSTALLATION.

PROJECT MAIN PARTICIPANTS

german cooperation DEUTSCHE ZUSAMMENARBEIT

giz Deutsche Gesellschaft für Internationale Zusammenarbeit (GIZ) GmbH

الجمهورية اللبنانية
وزارة التربية والتعليم العالي

CLIENT

LCEC
LEBANESE CENTER FOR ENERGY CONSERVATION
المركز اللبناني لترشيد الطاقة
efficient resources, sustainable achievements

CONSULTANT

INTERNATIONAL CONSULTANT - ICON

ICON INTERNATIONAL CONSULTANT

Beirut- Lebanon
P.O.BOX701, Antelias
Tel : + 961 4 404304 / 5
Fax : + 961 4 414250
e-mail: info@ICON-consultant.com
Website: www.ICON-consultant.com

Rev #	Last revision titles	Drawn by: dd/mm/yy	Verified by: dd/mm/yy	Approved by: dd/mm/yy	Status
00	Preliminary Design	R.R 20/5/23	R.B 20/5/23	P.Y 20/5/23	X

Issuer internal approval circuit and revision history

Project
SUFA AT PUBLIC SCHOOLS IN LEBANON

Project Work Package

Issuer
ICON

Phase / Nature
PRELIMINARY DESIGN PD

Primary Technical Discipline
ARCHITECTURE A – –

Drawing Number and Title
~~A-000~~ A-001

MATARIET EL CHOUMAR
PUBLIC SCHOOL - AS BUILT PLAN

ARCHITECTURE
FINISH LEVELS -------

Revision Number 00

Review Cycle :

Folio	Format	Scale
	A1	1/200

File spec : ----------

LEGEND:

OCP 01	OUTDOOR CLASSROOM PROTOTYPE 01
PM 01	KIDS PLAYGROUND MARKING
PM 02	PLAYGROUND MARKING BASKETBALL / FOOTBALL COURT
RB	RECYCLE BIN
CB	CONCRETE BENCH
CP	CONCRETE POT
SC	STEEL CANOPY
	INDOOR CO-CURRICULAR ACTIVITIES & RESERVATION FOR STORAGE

GENERAL NOTES

1. UNLESS OTHERWISE NOTED, ALL DIMENSIONS ARE IN CENTIMETERS.
2. DO NOT SCALE DRAWINGS, DIMENSIONS GIVEN SHALL GOVERN.
3. CONTRACTOR SHALL SUBMIT SHOP DRAWINGS AND SAMPLES OF ALL MATERIALS & COLORS FOR CLIENT & ARCHITECT APPROVAL.
4. ALL DIMENSIONS MUST BE VERIFIED BY CONTRACTORS BEFORE PREPARATION OF SHOP DRAWINGS.
5. THE ARCHITECT MUST BE INFORMED ABOUT CONTRADICTION OF ANY KIND BEFORE CONSTRUCTION BEGINS.
6. THE CONTRACTOR SHOULD CHECK THE PLOT AND SCHOOL BUILDING SERVICES CONNECTION POINTS, IN PARTICULAR FOR THE RAINWATER HARVESTING TANKS BEFORE INSTALLATION.
7. THE CONTRACTOR SHOULD REFER TO ALL PROTOTYPES DOCUMENTS PROVIDED BY LCEC THAT MUST BE READ IN COORDINATION WITH THE ACRHITECTURAL DRAWINGS.

PROJECT MAIN PARTICIPANTS

german cooperation
DEUTSCHE ZUSAMMENARBEIT

giz Deutsche Gesellschaft für Internationale Zusammenarbeit (GIZ) GmbH

الجمهورية اللبنانية
وزارة التربية والتعليم العالي

CLIENT

LCEC
LEBANESE CENTER FOR ENERGY CONSERVATION
المركز اللبناني لحفظ الطاقة
efficient resources, sustainable achievements

CONSULTANT

INTERNATIONAL CONSULTANT - ICON

ICON INTERNATIONAL CONSULTANT
Beirut- Lebanon
P.O.BOX701, Antelias
Tel : + 961 4 404304 / 5
Fax : + 961 4 414250
e-mail: info@icon-py.com
Website: www.icon-py.com

Rev #	Last revision titles	Drawn by: dd/mm/yy	Verified by: dd/mm/yy	Approved by: dd/mm/yy	Status
01	Final Design	R.R 31/7/23	R.B 31/7/23	P.Y 31/7/23	X
00	Final Design	R.R 16/6/23	R.B 16/6/23	P.Y 18/6/23	X

Issuer internal approval circuit and revision history

Project
SUFA AT PUBLIC SCHOOLS IN LEBANON

Project Work Package

Issuer
ICON

Phase / Nature: FD
FINAL DESIGN

Primary Technical Discipline: A – –
ARCHITECTURE

Drawing Number and Title: A-101
MATARIAT EL CHOUMAR INTERMEDIATE PUBLIC SCHOOL SAIDA - PLAN

ARCHITECTURE
FINISH LEVELS --------

Revision Number: 01

Review Cycle :

Folio	Format	Scale
	A1	1/200

File spec : ----------

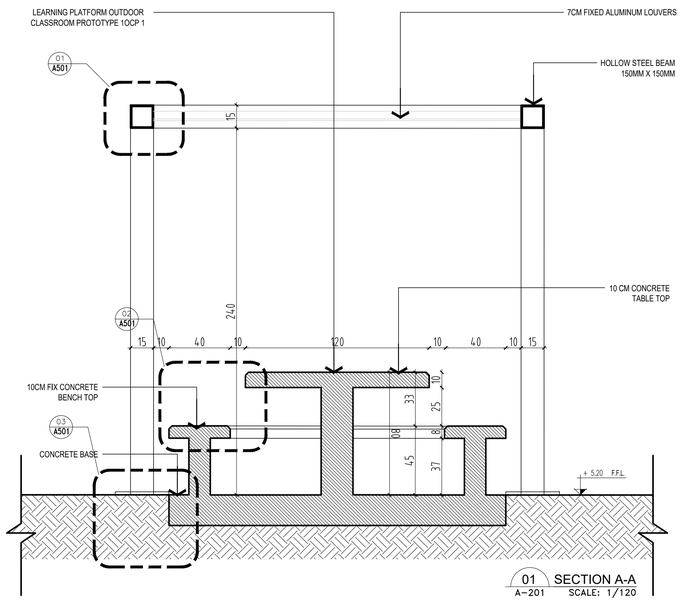

01 SECTION A-A
A-201 SCALE: 1/120

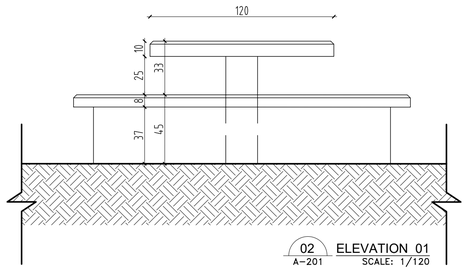

02 ELEVATION 01
A-201 SCALE: 1/120

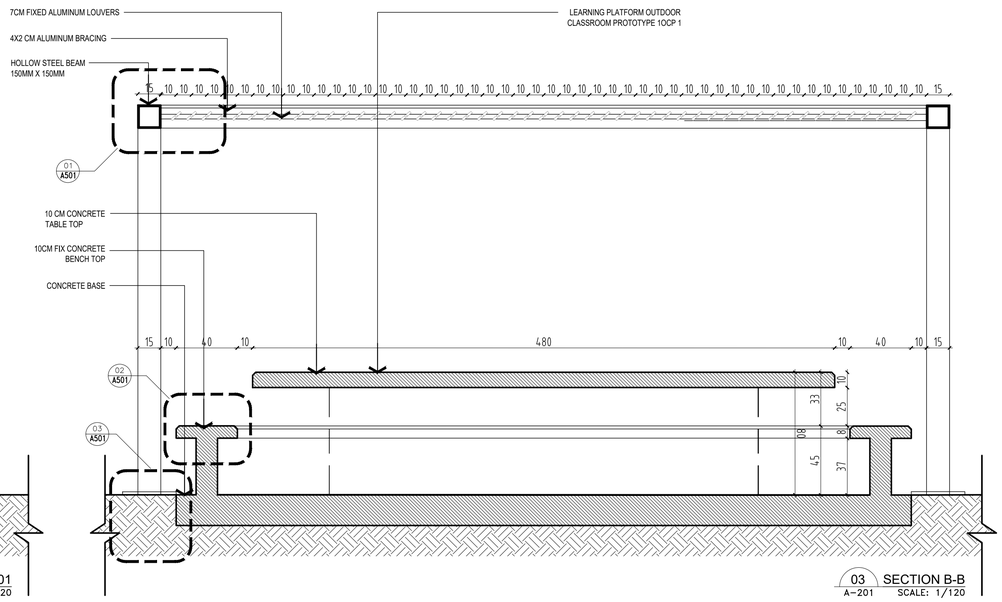

03 SECTION B-B
A-201 SCALE: 1/120

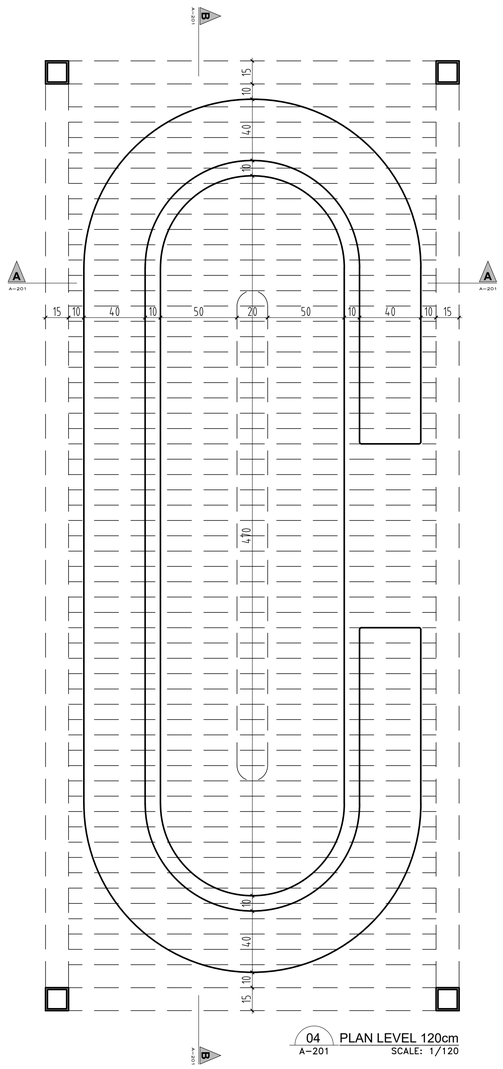

04 PLAN LEVEL 120cm
A-201 SCALE: 1/120

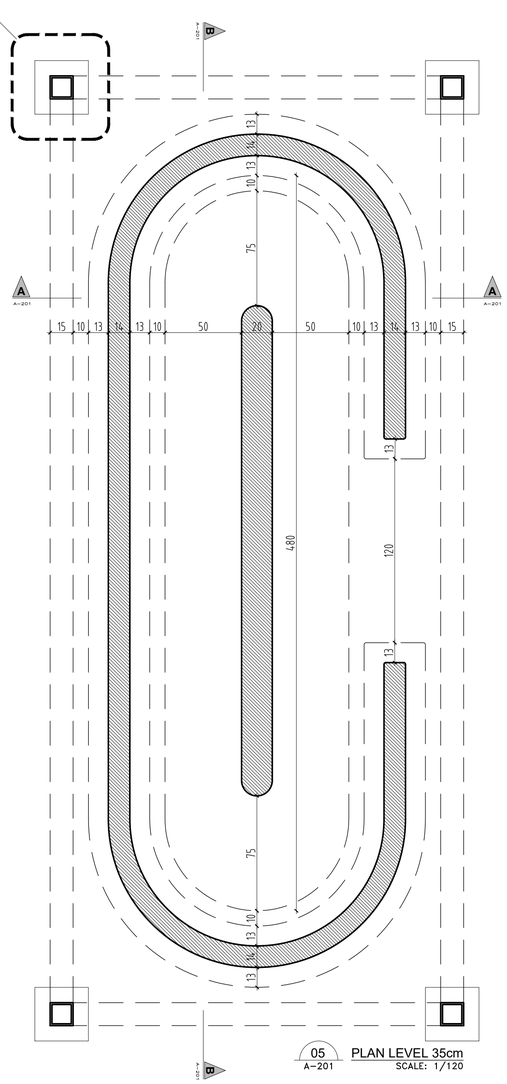

05 PLAN LEVEL 35cm
A-201 SCALE: 1/120

06 ELEVATION 02
A-201 SCALE: 1/120

GENERAL NOTES

1. UNLESS OTHERWISE NOTED, ALL DIMENSIONS ARE IN CENTIMETERS.
2. DO NOT SCALE DRAWINGS, DIMENSIONS GIVEN SHALL GOVERN.
3. CONTRACTOR SHALL SUBMIT SHOP DRAWINGS AND SAMPLES OF ALL MATERIALS & COLORS FOR CLIENT & ARCHITECT APPROVAL.
4. ALL DIMENSIONS MUST BE VERIFIED BY CONTRACTORS BEFORE PREPARATION OF SHOP DRAWINGS.
5. THE ARCHITECT MUST BE INFORMED ABOUT CONTRADICTION OF ANY KIND BEFORE CONSTRUCTION BEGINS.
6. THE CONTRACTOR SHOULD CHECK THE PLOT AND SCHOOL BUILDING SERVICES CONNECTION POINTS, IN PARTICULAR FOR THE RAINWATER HARVESTING TANKS BEFORE INSTALLATION.
7. THE CONTRACTOR SHOULD REFER TO ALL PROTOTYPES DOCUMENTS PROVIDED BY LCEC THAT MUST BE READ IN COORDINATION WITH THE ACRHITECTURAL DRAWINGS.

PROJECT MAIN PARTICIPANTS

german cooperation
DEUTSCHE ZUSAMMENARBEIT

giz Deutsche Gesellschaft für Internationale Zusammenarbeit (GIZ) GmbH

الجمهورية اللبنانية
وزارة التربية والتعليم العالي

CLIENT

LCEC
LEBANESE CENTER FOR ENERGY CONSERVATION
المركز اللبناني لدعم الطاقة
efficient resources, sustainable achievements

CONSULTANT

INTERNATIONAL CONSULTANT - ICON

iCON INTERNATIONAL CONSULTANT
Beirut- Lebanon
P.O.BOX701, Antelias
Tel : + 961 4 404304 / 5
Fax : + 961 4 414250
e-mail: info@icon-py.com
Website: www.icon-py.com

Rev #	Last revision titles	Drawn by: dd/mm/yy	Verified by: dd/mm/yy	Approved by: dd/mm/yy	Status
01	Final Design	R.R 31/7/23	R.B 31/7/23	P.Y 31/7/23	X
00	Final Design	R.R 16/6/23	R.B 16/6/23	P.Y 18/6/23	X

Issuer internal approval circuit and revision history

Project
SUFA AT PUBLIC SCHOOLS IN LEBANON

Project Work Package

Issuer
ICON

Phase / Nature: FD
FINAL DESIGN

Primary Technical Discipline: A--
ARCHITECTURE

Drawing Number and Title: A-201
MATARIAT EL CHOUMAR INTERMEDIATE PUBLIC SCHOOL SAIDA - OUTDOOR CLASSROOM PROTOTYPE 1 - DETAILS

ARCHITECTURE
FINISH LEVELS --------

Revision Number: 01

Review Cycle :

Folio	Format	Scale
	A1	1/20

File spec : ----------

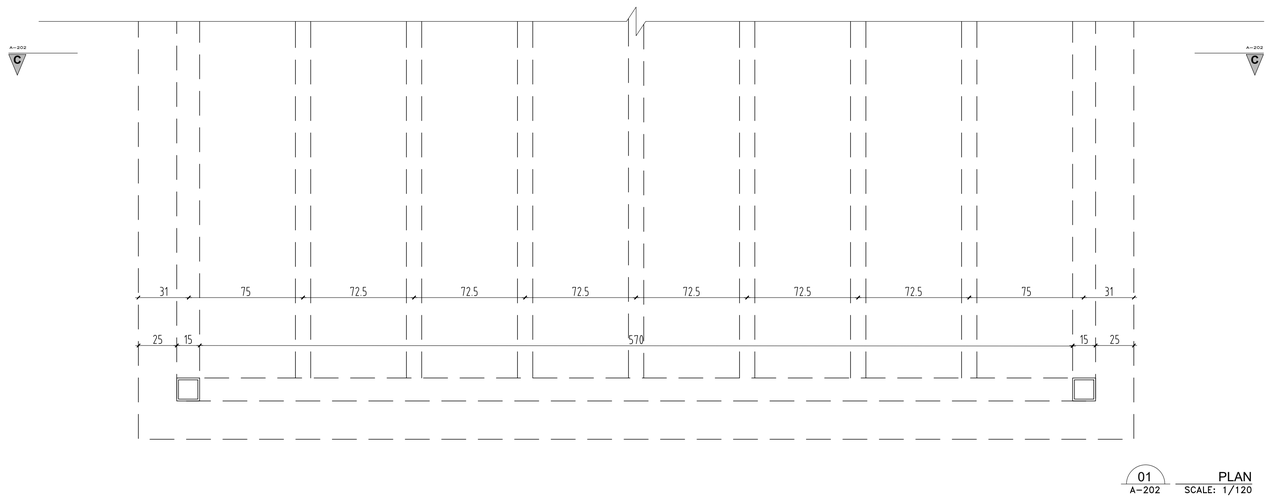

01 A-202 PLAN SCALE: 1/120

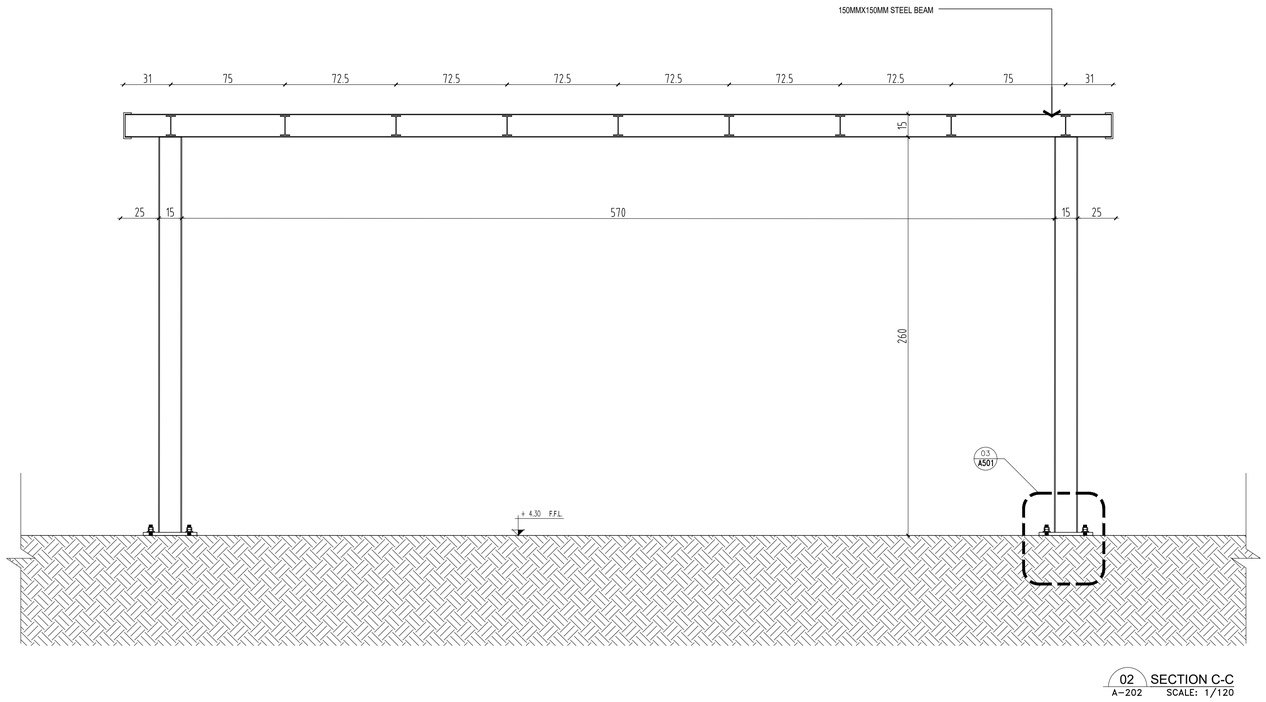

02 A-202 SECTION C-C SCALE: 1/120

GENERAL NOTES

1. UNLESS OTHERWISE NOTED, ALL DIMENSIONS ARE IN CENTIMETERS.
2. DO NOT SCALE DRAWINGS, DIMENSIONS GIVEN SHALL GOVERN.
3. CONTRACTOR SHALL SUBMIT SHOP DRAWINGS AND SAMPLES OF ALL MATERIALS & COLORS FOR CLIENT & ARCHITECT APPROVAL.
4. ALL DIMENSIONS MUST BE VERIFIED BY CONTRACTORS BEFORE PREPARATION OF SHOP DRAWINGS.
5. THE ARCHITECT MUST BE INFORMED ABOUT CONTRADICTION OF ANY KIND BEFORE CONSTRUCTION BEGINS.
6. THE CONTRACTOR SHOULD CHECK THE PLOT AND SCHOOL BUILDING SERVICES CONNECTION POINTS, IN PARTICULAR FOR THE RAINWATER HARVESTING TANKS BEFORE INSTALLATION.
7. THE CONTRACTOR SHOULD REFER TO ALL PROTOTYPES DOCUMENTS PROVIDED BY LCEC THAT MUST BE READ IN COORDINATION WITH THE ACRHITECTURAL DRAWINGS.

PROJECT MAIN PARTICIPANTS

german cooperation
DEUTSCHE ZUSAMMENARBEIT

giz Deutsche Gesellschaft für Internationale Zusammenarbeit (GIZ) GmbH

الجمهورية اللبنانية
وزارة التربية والتعليم العالي

CLIENT

LCEC
LEBANESE CENTER FOR ENERGY CONSERVATION
المركز اللبناني لدعم الطاقة
efficient resources, sustainable achievements

CONSULTANT

INTERNATIONAL CONSULTANT - ICON

ICON INTERNATIONAL CONSULTANT
Beirut- Lebanon
P.O.BOX701, Antelias
Tel : + 961 4 404304 / 5
Fax : + 961 4 414250
e-mail: info@icon-py.com
Website: www.icon-py.com

Rev #	Last revision titles	Drawn by: dd/mm/yy	Verified by: dd/mm/yy	Approved by: dd/mm/yy	Status
01	Final Design	R.R 31/7/23	R.B 31/7/23	P.Y 31/7/23	X
00	Final Design	R.R 16/6/23	R.B 16/6/23	P.Y 18/6/23	X

Issuer internal approval circuit and revision history

Project
SUFA AT PUBLIC SCHOOLS IN LEBANON

Project Work Package

Issuer
ICON

Phase / Nature: FD
FINAL DESIGN

Primary Technical Discipline: A--
ARCHITECTURE

Drawing Number and Title: A-202

MATARIAT EL CHOUMAR INTERMEDIATE PUBLIC SCHOOL SAIDA - CANOPY DETAILS

ARCHITECTURE
FINISH LEVELS -------

Revision Number: 01

Review Cycle :

Folio	Format	Scale
	A1	1/20

File spec : ----------

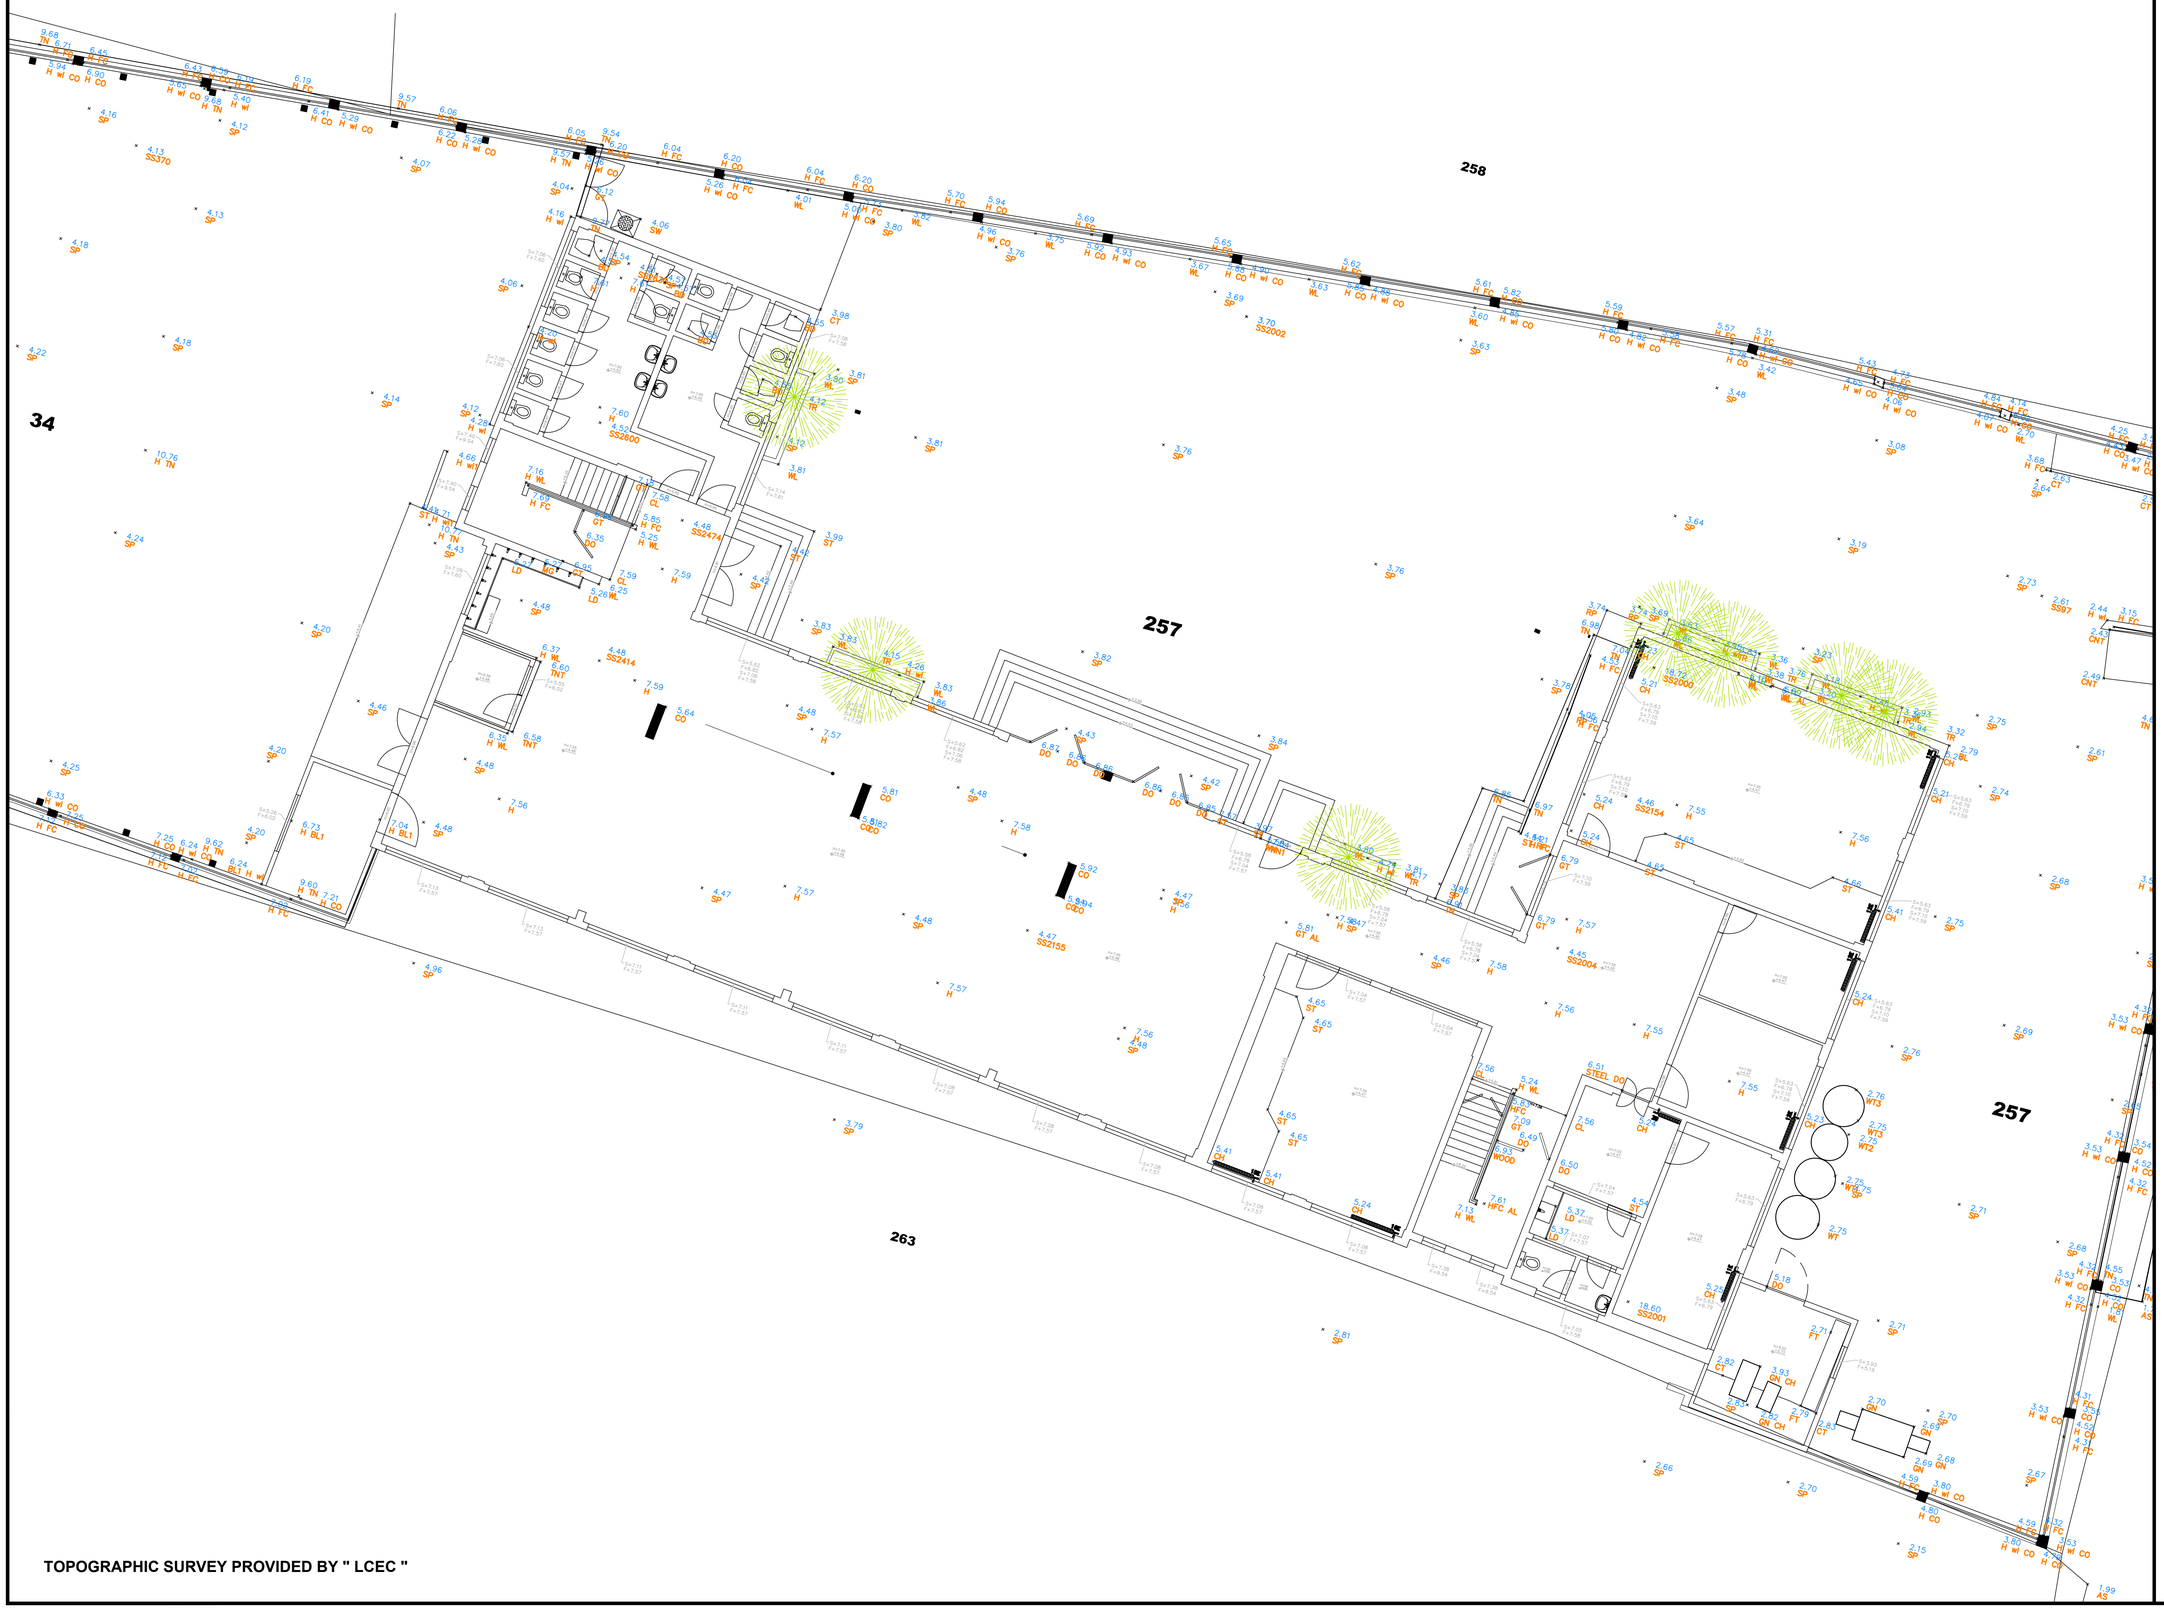

TOPOGRAPHIC SURVEY PROVIDED BY " LCEC "

GENERAL NOTES

1. UNLESS OTHERWISE NOTED, ALL DIMENSIONS ARE IN CENTIMETERS.
2. DO NOT SCALE DRAWINGS, DIMENSIONS GIVEN SHALL GOVERN.
3. CONTRACTOR SHALL SUBMIT SHOP DRAWINGS AND SAMPLES OF ALL MATERIALS & COLORS FOR CLIENT & ARCHITECT APPROVAL.
4. ALL DIMENSIONS MUST BE VERIFIED BY CONTRACTORS BEFORE PREPARATION OF SHOP DRAWINGS.
5. THE ARCHITECT MUST BE INFORMED ABOUT CONTRADICTION OF ANY KIND BEFORE CONSTRUCTION BEGINS.
6. THE CONTRACTOR SHOULD CHECK THE PLOT AND SCHOOL BUILDING SERVICES CONNECTION POINTS, IN PARTICULAR FOR THE RAINWATER HARVESTING TANKS BEFORE INSTALLATION.
7. THE CONTRACTOR SHOULD REFER TO ALL PROTOTYPES DOCUMENTS PROVIDED BY LCEC THAT MUST BE READ IN COORDINATION WITH THE ACRHITECTURAL DRAWINGS.

PROJECT MAIN PARTICIPANTS

german cooperation
DEUTSCHE ZUSAMMENARBEIT

giz Deutsche Gesellschaft für Internationale Zusammenarbeit (GIZ) GmbH

الجمهورية اللبنانية
وزارة التربية والتعليم العالي

CLIENT

LCEC
LEBANESE CENTER FOR ENERGY CONSERVATION
المركز اللبناني لحفظ الطاقة
efficient resources, sustainable achievements

CONSULTANT

INTERNATIONAL CONSULTANT - ICON

ICON INTERNATIONAL CONSULTANT
Beirut- Lebanon
P.O.BOX701, Antelias
Tel : + 961 4 404304 / 5
Fax : + 961 4 414250
e-mail: info@icon-py.com
Website: www.icon-py.com

Rev #	Last revision titles	Drawn by: dd/mm/yy	Verified by: dd/mm/yy	Approved by: dd/mm/yy	Status
01	Final Design	R.R 31/7/23	R.B 31/7/23	P.Y 31/7/23	X
00	Final Design	R.R 16/6/23	R.B 16/6/23	P.Y 18/6/23	X

Issuer internal approval circuit and revision history

Project
SUFA AT PUBLIC SCHOOLS IN LEBANON

Project Work Package

Issuer
ICON

Phase / Nature: FD
FINAL DESIGN

Primary Technical Discipline: A – –
ARCHITECTURE

Drawing Number and Title: A-000

ZEBDINE INTERMEDIATE PUBLIC SCHOOL NABATIEH AS BUILT PLAN

ARCHITECTURE
FINISH LEVELS -------

Revision Number: 01

Review Cycle :

Folio	Format	Scale
	A1	1/100

File spec : ----------

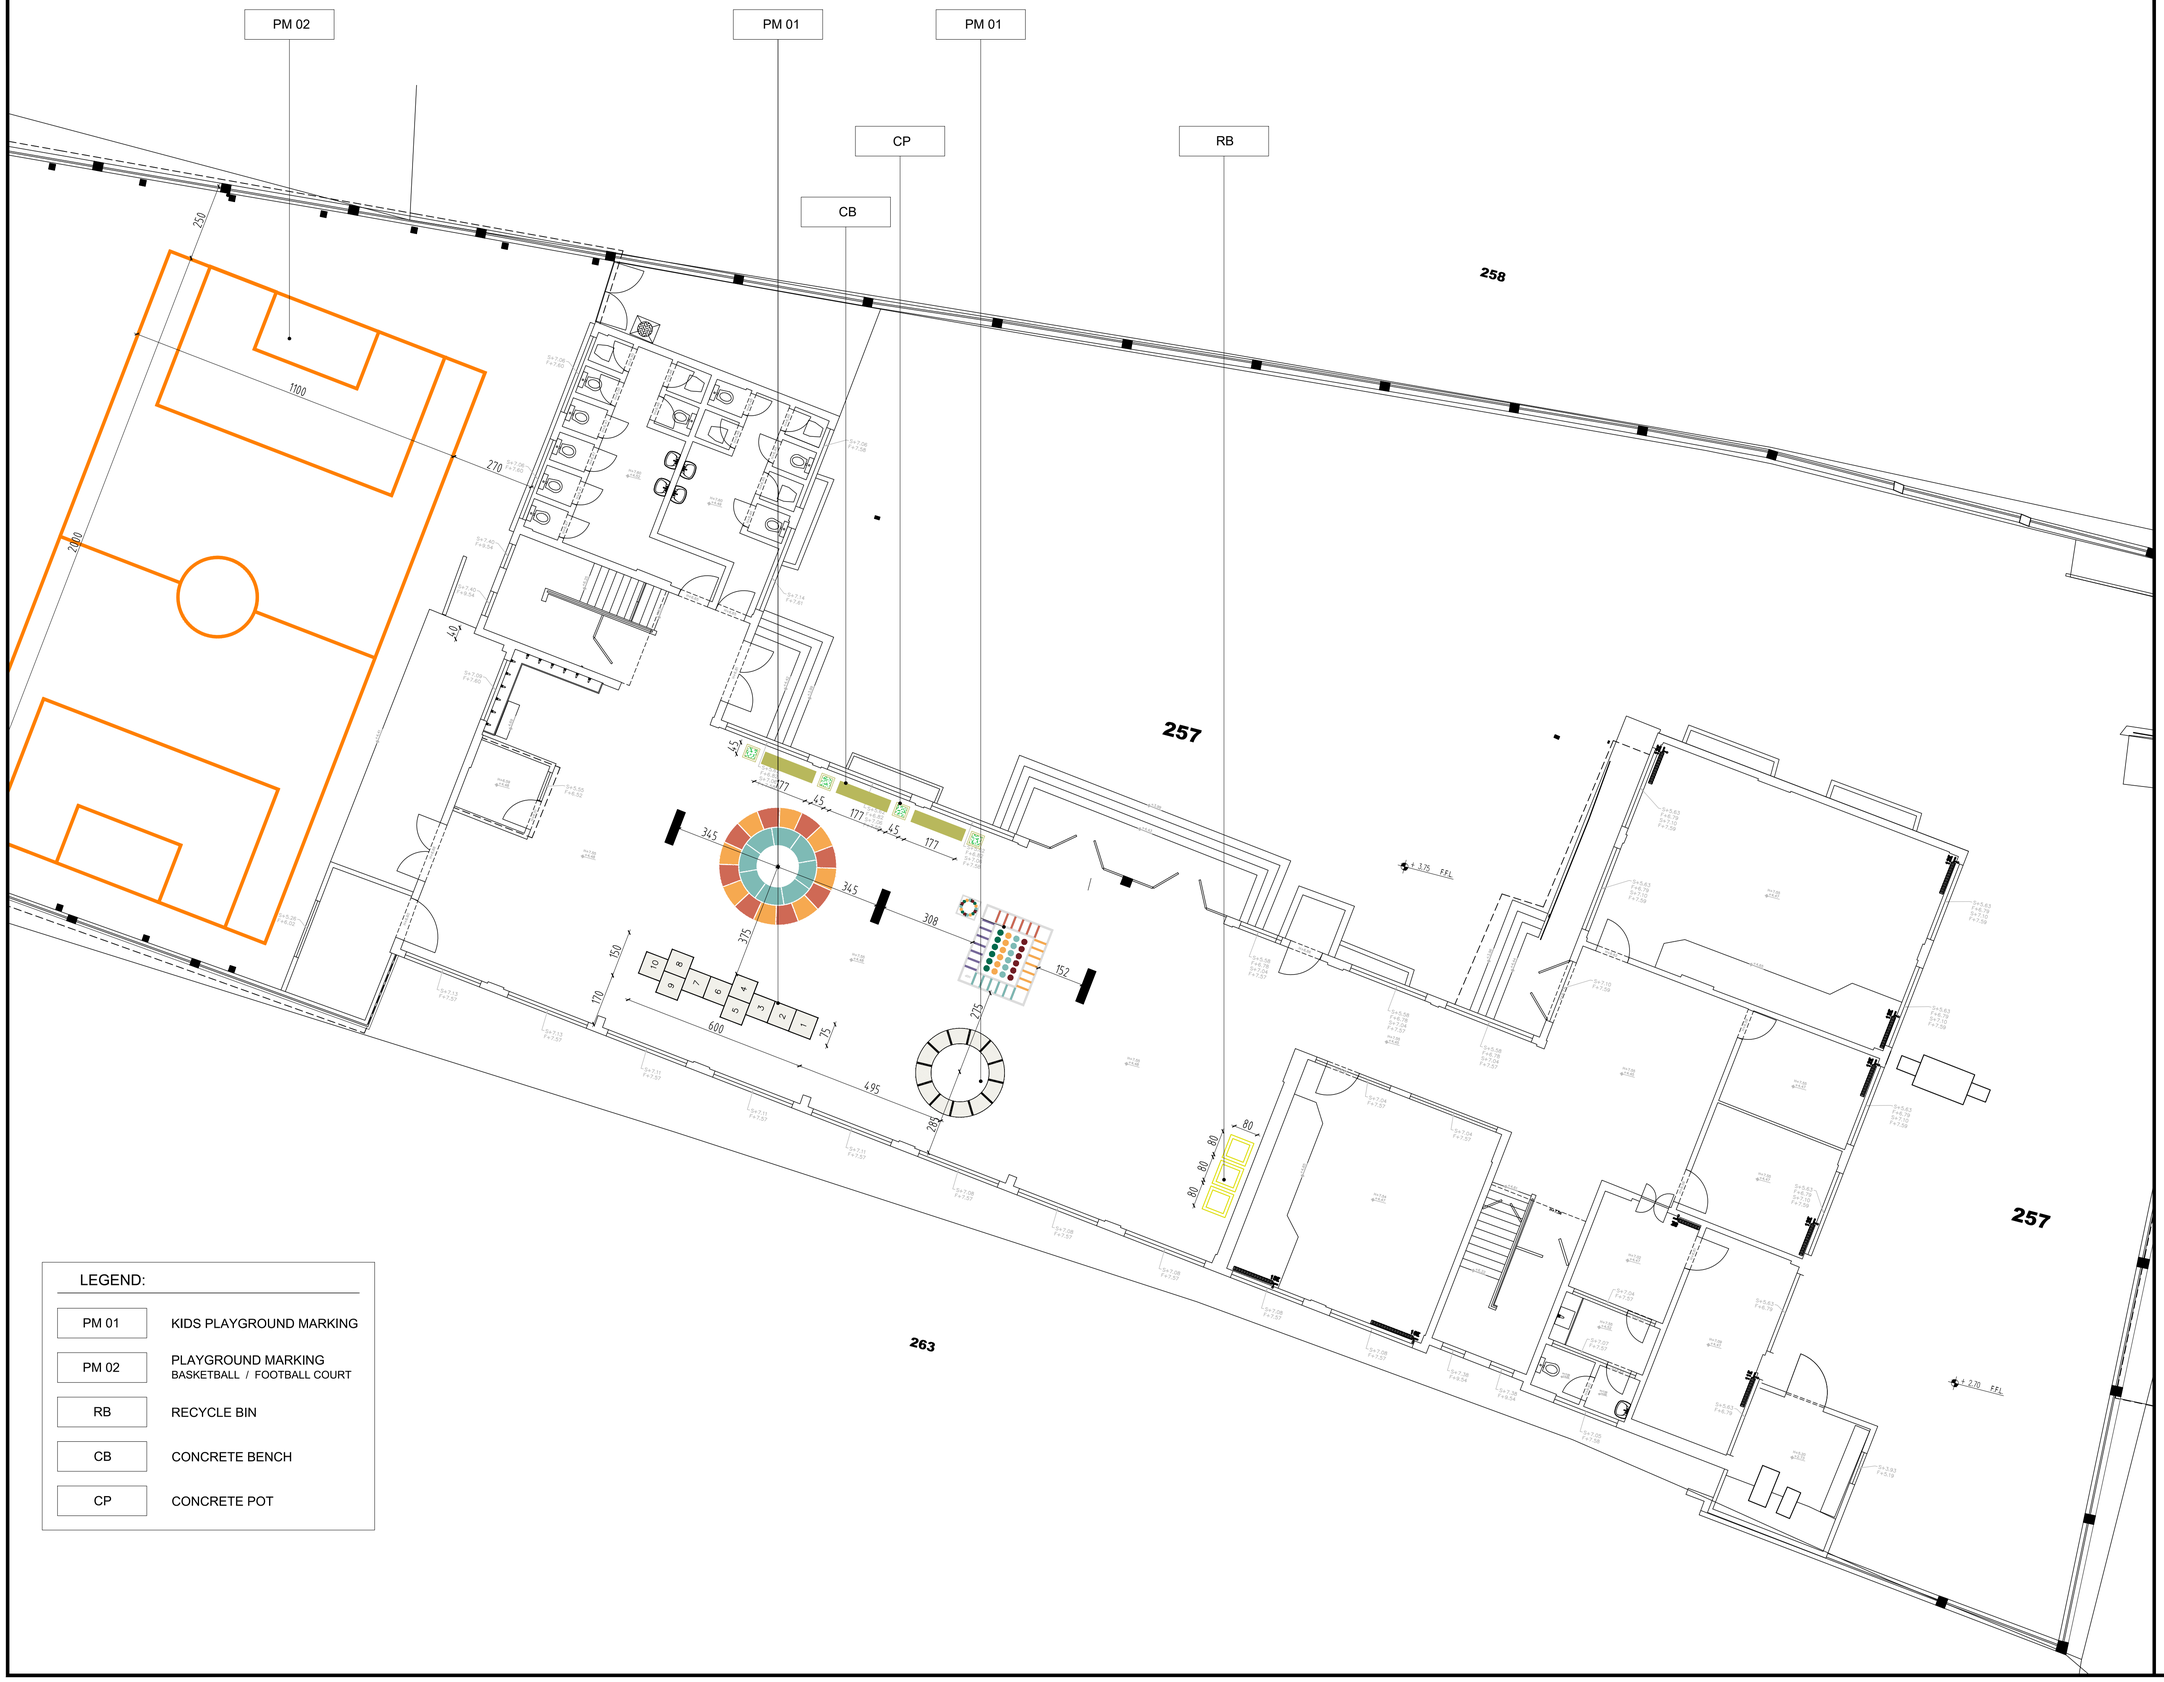

LEGEND:

PM 01	KIDS PLAYGROUND MARKING
PM 02	PLAYGROUND MARKING BASKETBALL / FOOTBALL COURT
RB	RECYCLE BIN
CB	CONCRETE BENCH
CP	CONCRETE POT

GENERAL NOTES

1. UNLESS OTHERWISE NOTED, ALL DIMENSIONS ARE IN CENTIMETERS.
2. DO NOT SCALE DRAWINGS, DIMENSIONS GIVEN SHALL GOVERN.
3. CONTRACTOR SHALL SUBMIT SHOP DRAWINGS AND SAMPLES OF ALL MATERIALS & COLORS FOR CLIENT & ARCHITECT APPROVAL.
4. ALL DIMENSIONS MUST BE VERIFIED BY CONTRACTORS BEFORE PREPARATION OF SHOP DRAWINGS.
5. THE ARCHITECT MUST BE INFORMED ABOUT CONTRADICTION OF ANY KIND BEFORE CONSTRUCTION BEGINS.
6. THE CONTRACTOR SHOULD CHECK THE PLOT AND SCHOOL BUILDING SERVICES CONNECTION POINTS, IN PARTICULAR FOR THE RAINWATER HARVESTING TANKS BEFORE INSTALLATION.
7. THE CONTRACTOR SHOULD REFER TO ALL PROTOTYPES DOCUMENTS PROVIDED BY LCEC THAT MUST BE READ IN COORDINATION WITH THE ACRHITECTURAL DRAWINGS.

PROJECT MAIN PARTICIPANTS

german cooperation
DEUTSCHE ZUSAMMENARBEIT

giz Deutsche Gesellschaft für Internationale Zusammenarbeit (GIZ) GmbH

الجمهورية اللبنانية
وزارة التربية والتعليم العالي

CLIENT

LCEC
LEBANESE CENTER FOR ENERGY CONSERVATION
المركز اللبناني لحفظ الطاقة
efficient resources, sustainable achievements

CONSULTANT

INTERNATIONAL CONSULTANT - ICON

ICON INTERNATIONAL CONSULTANT
Beirut- Lebanon
P.O.BOX701, Antelias
Tel : + 961 4 404304 / 5
Fax : + 961 4 414250
e-mail: info@icon-py.com
Website: www.icon-py.com

Rev #	Last revision titles	Drawn by: dd/mm/yy	Verified by: dd/mm/yy	Approved by: dd/mm/yy	Status
01	Final Design	R.R 31/7/23	R.B 31/7/23	P.Y 31/7/23	X
00	Final Design	R.R 16/6/23	R.B 16/6/23	P.Y 18/6/23	X

Issuer internal approval circuit and revision history

Project
SUFA AT PUBLIC SCHOOLS IN LEBANON

Project Work Package

Issuer
ICON

Phase / Nature
FINAL DESIGN FD

Primary Technical Discipline
ARCHITECTURE A--

Drawing Number and Title
A-101

ZEBDINE INTERMEDIATE PUBLIC SCHOOL NABATIEH - PLAN

ARCHITECTURE
FINISH LEVELS -------

Revision Number 01

Review Cycle :

Folio	Format	Scale
	A1	1/100

File spec : ----------

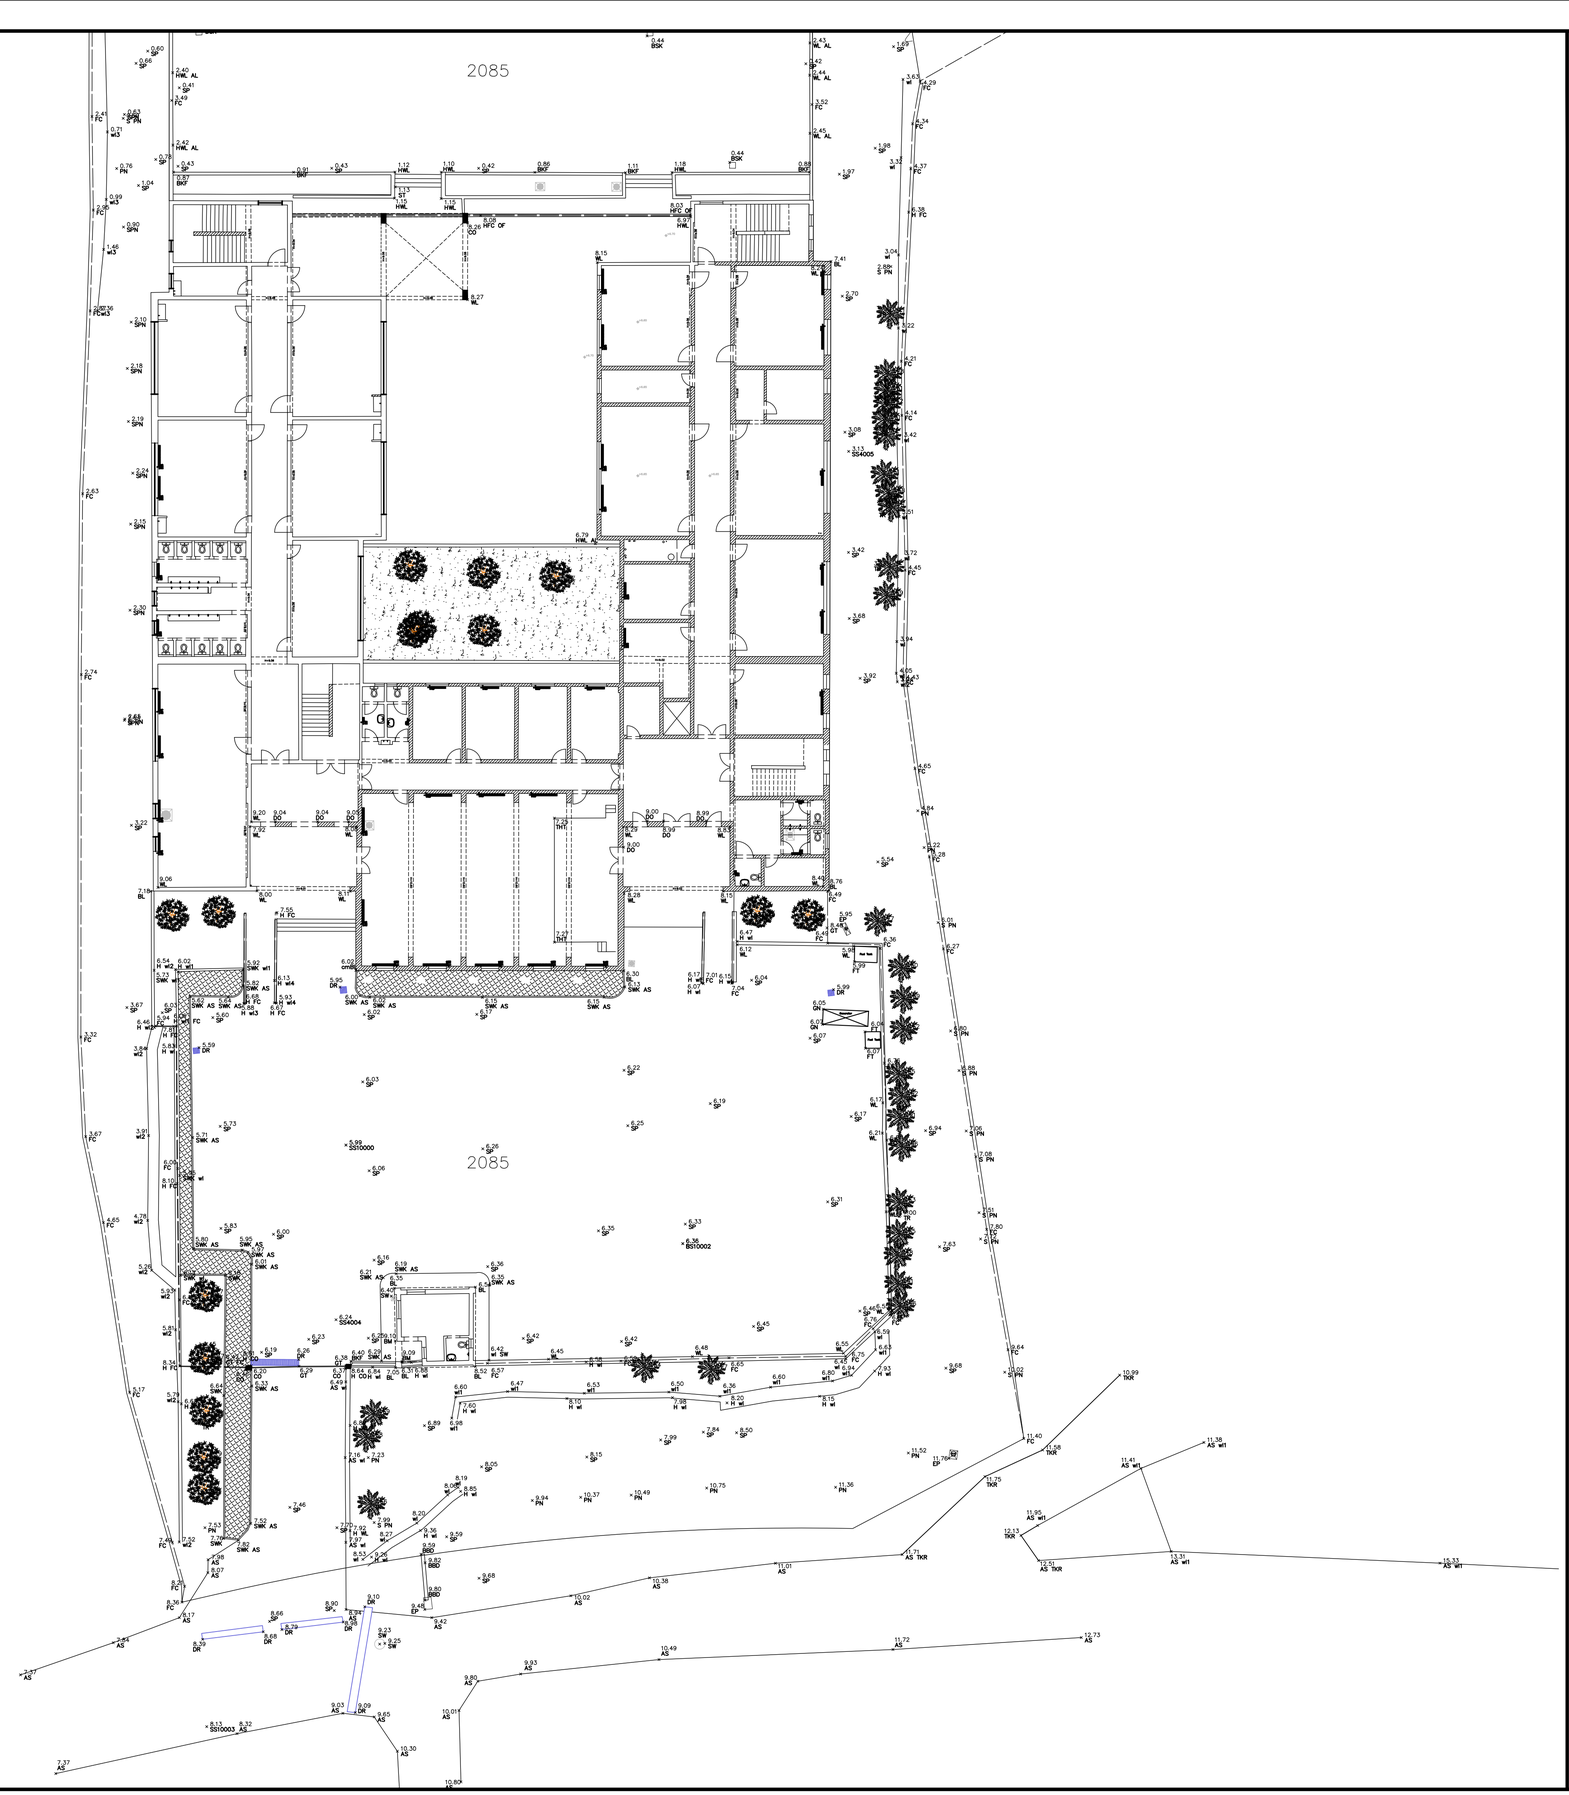

GENERAL NOTES

1. UNLESS OTHERWISE NOTED, ALL DIMENSIONS ARE IN CENTIMETERS.
2. DO NOT SCALE DRAWINGS, DIMENSIONS GIVEN SHALL GOVERN.
3. CONTRACTOR SHALL SUBMIT SHOP DRAWINGS AND SAMPLES OF ALL MATERIALS & COLORS FOR CLIENT & ARCHITECT APPROVAL.
4. ALL DIMENSIONS MUST BE VERIFIED BY CONTRACTORS BEFORE PREPARATION OF SHOP DRAWINGS.
5. THE ARCHITECT MUST BE INFORMED ABOUT CONTRADICTION OF ANY KIND BEFORE CONSTRUCTION BEGINS.
6. THE CONTRACTOR SHOULD CHECK THE PLOT AND SCHOOL BUILDING SERVICES CONNECTION POINTS, IN PARTICULAR FOR THE RAINWATER HARVESTING TANKS BEFORE INSTALLATION.
7. THE CONTRACTOR SHOULD REFER TO ALL PROTOTYPES DOCUMENTS PROVIDED BY LCEC THAT MUST BE READ IN COORDINATION WITH THE ACRHITECTURAL DRAWINGS.

PROJECT MAIN PARTICIPANTS

german cooperation
DEUTSCHE ZUSAMMENARBEIT

giz Deutsche Gesellschaft für Internationale Zusammenarbeit (GIZ) GmbH

الجمهورية اللبنانية
وزارة التربية والتعليم العالي

CLIENT

LCEC
LEBANESE CENTER FOR ENERGY CONSERVATION
المركز اللبناني لترشيد الطاقة
efficient resources, sustainable achievements

CONSULTANT

INTERNATIONAL CONSULTANT - ICON

ICON INTERNATIONAL CONSULTANT
Beirut- Lebanon
P.O.BOX701, Antelias
Tel : +961 4 404304 / 5
Fax : + 961 4 414250
e-mail: info@icon-py.com
Website: www.icon-py.com

Rev #		Drawn by: dd/mm/yy	Verified by: dd/mm/yy	Approved by: dd/mm/yy	Status
01	Final Design	R.R 31/7/23	R.B 31/7/23	P.Y 31/7/23	X
00	Final Design	R.R 16/6/23	R.B 16/6/23	P.Y 18/6/23	X

Issuer internal approval circuit and revision history

Project
SUFA AT PUBLIC SCHOOLS IN LEBANON

Project Work Package

Issuer
ICON

Phase / Nature: FD
FINAL DESIGN

Primary Technical Discipline: A--
ARCHITECTURE

Drawing Number and Title: A-101
BAAKLIN MIXED INTERMEDIATE PUBLIC SCHOOL SHOUF - PLAN

ARCHITECTURE
FINISH LEVELS -------

Revision Number: 01

Review Cycle :

Folio	Format	Scale
	A1	1/200

File spec : ----------

LEGEND:

OCP 01	OUTDOOR CLASSROOM PROTOTYPE 01
PM 01	KIDS PLAYGROUND MARKING
PM 02	PLAYGROUND MARKING BASKETBALL / FOOTBALL COURT
RH	RAIN WATER HARVESTING
CS	COMPOST STATION
SC	STEEL CANOPY
RB	RECYCLE BIN
PS	PLANTING SELECTION
	INDOOR CO-CURRICULAR ACTIVITIES & RESERVATION FOR STORAGE

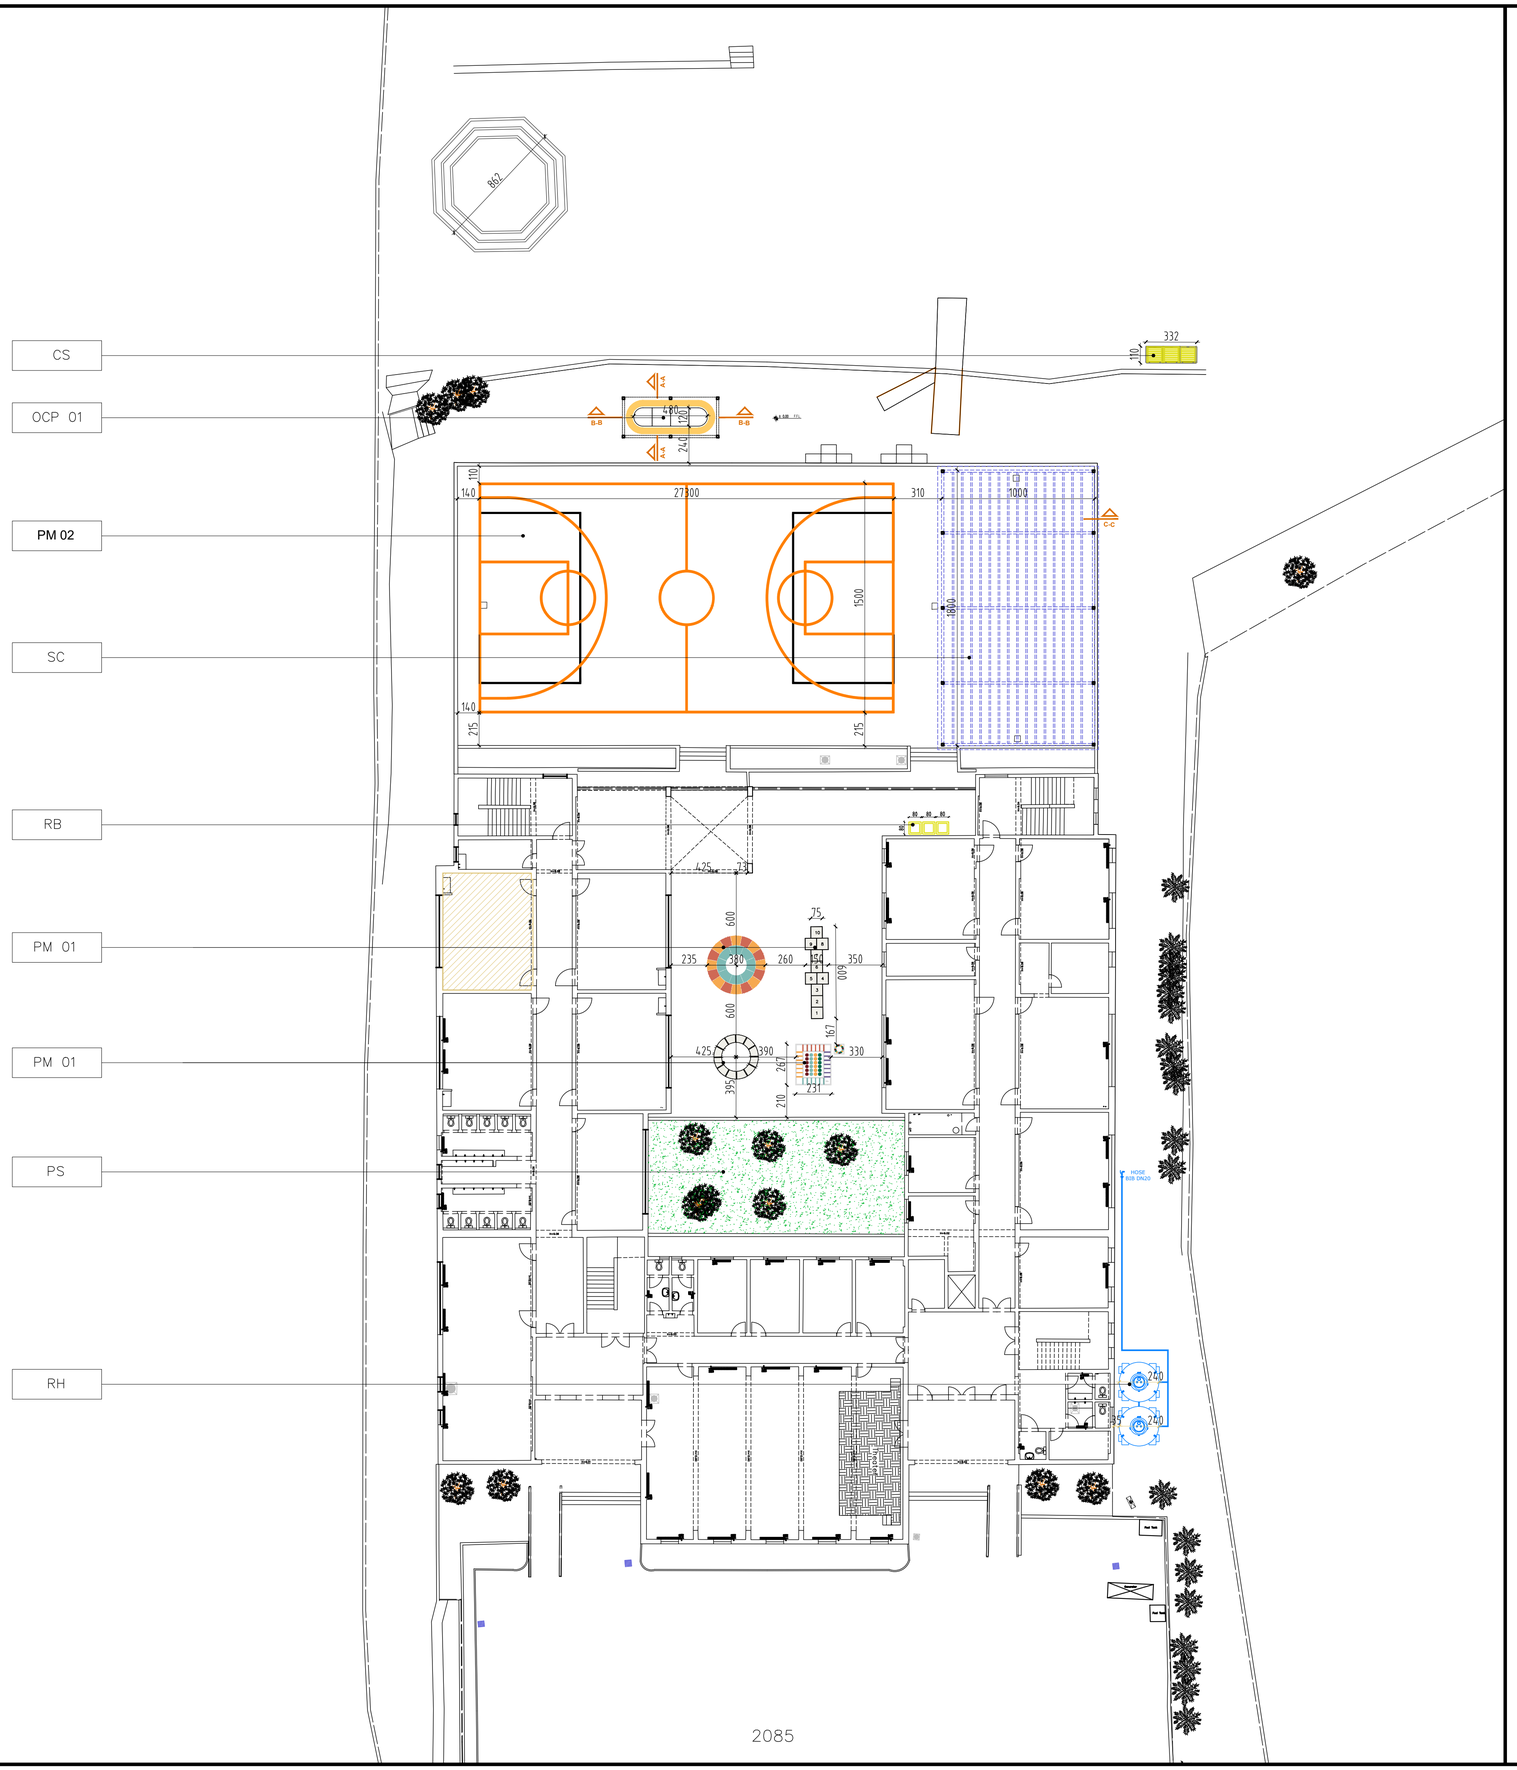

GENERAL NOTES

1. UNLESS OTHERWISE NOTED, ALL DIMENSIONS ARE IN CENTIMETERS.
2. DO NOT SCALE DRAWINGS, DIMENSIONS GIVEN SHALL GOVERN.
3. CONTRACTOR SHALL SUBMIT SHOP DRAWINGS AND SAMPLES OF ALL MATERIALS & COLORS FOR CLIENT & ARCHITECT APPROVAL.
4. ALL DIMENSIONS MUST BE VERIFIED BY CONTRACTORS BEFORE PREPARATION OF SHOP DRAWINGS.
5. THE ARCHITECT MUST BE INFORMED ABOUT CONTRADICTION OF ANY KIND BEFORE CONSTRUCTION BEGINS.
6. THE CONTRACTOR SHOULD CHECK THE PLOT AND SCHOOL BUILDING SERVICES CONNECTION POINTS, IN PARTICULAR FOR THE RAINWATER HARVESTING TANKS BEFORE INSTALLATION.
7. THE CONTRACTOR SHOULD REFER TO ALL PROTOTYPES DOCUMENTS PROVIDED BY LCEC THAT MUST BE READ IN COORDINATION WITH THE ACRHITECTURAL DRAWINGS.

PROJECT MAIN PARTICIPANTS

german cooperation
DEUTSCHE ZUSAMMENARBEIT

giz Deutsche Gesellschaft für Internationale Zusammenarbeit (GIZ) GmbH

الجمهورية اللبنانية
وزارة التربية والتعليم العالي

CLIENT

LCEC
LEBANESE CENTER FOR ENERGY CONSERVATION
المركز اللبناني لحفظ الطاقة
efficient resources, sustainable achievements

CONSULTANT

INTERNATIONAL CONSULTANT - ICON

ICON INTERNATIONAL CONSULTANT
Beirut- Lebanon
P.O.BOX701, Antelias
Tel : + 961 4 404304 / 5
Fax : + 961 4 414250
e-mail: info@icon-py.com
Website: www.icon-py.com

Rev #	Last revision titles	Drawn by: dd/mm/yy	Verified by: dd/mm/yy	Approved by: dd/mm/yy	Status
01	Final Design	R.R 31/7/23	R.B 31/7/23	P.Y 31/7/23	X
00	Final Design	R.R 16/6/23	R.B 16/6/23	P.Y 18/6/23	X

Issuer internal approval circuit and revision history

Project ------

SUFA AT PUBLIC SCHOOLS IN LEBANON

Project Work Package

Issuer

ICON

Phase / Nature FD

FINAL DESIGN

Primary Technical Discipline A--

ARCHITECTURE

Drawing Number and Title A-101

BAAKLIN MIXED INTERMEDIATE PUBLIC SCHOOL SHOUF - PLAN

ARCHITECTURE

FINISH LEVELS -------

Revision Number 01

Review Cycle :

Folio	Format	Scale
	A1	1/200

File spec : ----------

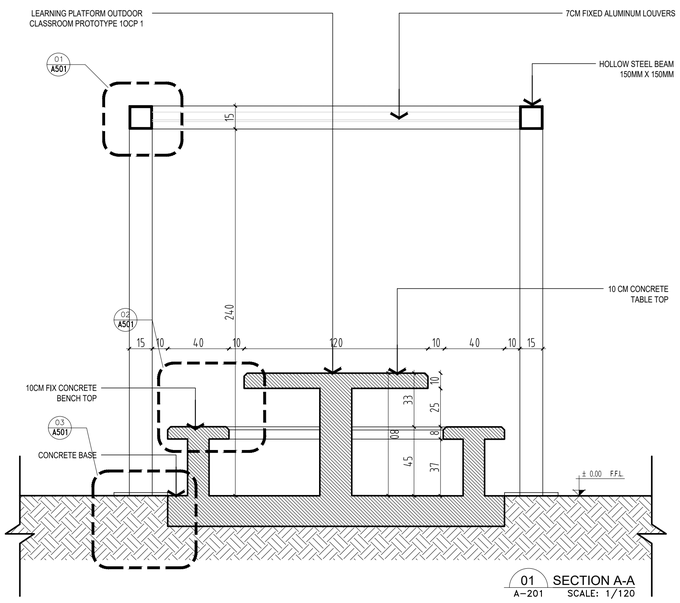

01 SECTION A-A
A-201 SCALE: 1/120

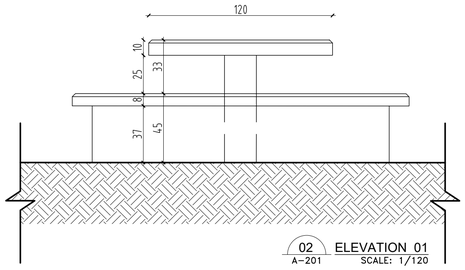

02 ELEVATION 01
A-201 SCALE: 1/120

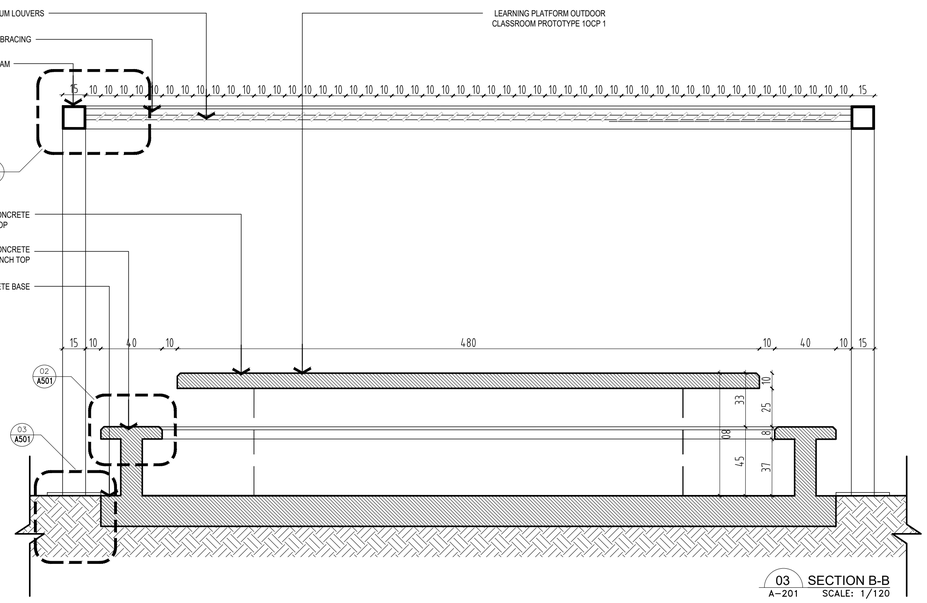

03 SECTION B-B
A-201 SCALE: 1/120

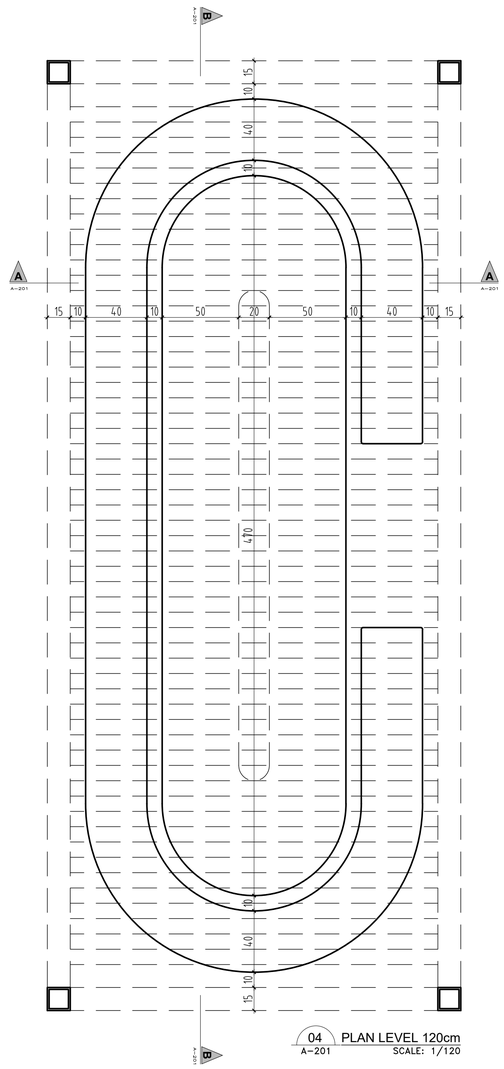

04 PLAN LEVEL 120cm
A-201 SCALE: 1/120

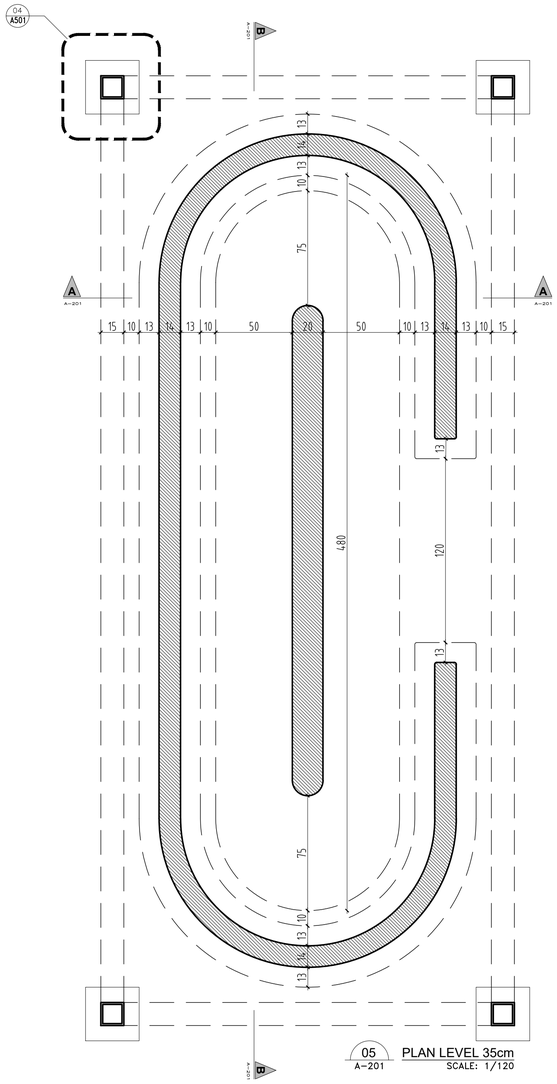

05 PLAN LEVEL 35cm
A-201 SCALE: 1/120

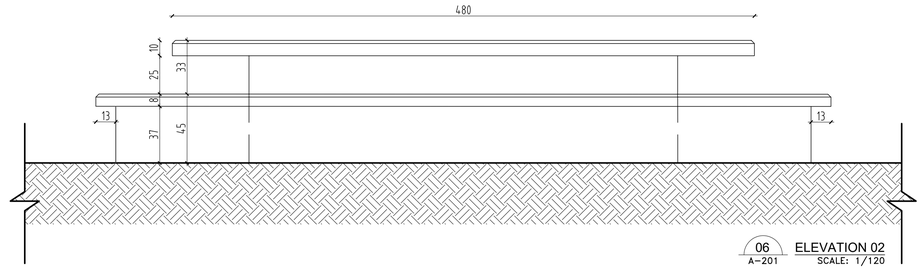

06 ELEVATION 02
A-201 SCALE: 1/120

GENERAL NOTES

1. UNLESS OTHERWISE NOTED, ALL DIMENSIONS ARE IN CENTIMETERS.
2. DO NOT SCALE DRAWINGS, DIMENSIONS GIVEN SHALL GOVERN.
3. CONTRACTOR SHALL SUBMIT SHOP DRAWINGS AND SAMPLES OF ALL MATERIALS & COLORS FOR CLIENT & ARCHITECT APPROVAL.
4. ALL DIMENSIONS MUST BE VERIFIED BY CONTRACTORS BEFORE PREPARATION OF SHOP DRAWINGS.
5. THE ARCHITECT MUST BE INFORMED ABOUT CONTRADICTION OF ANY KIND BEFORE CONSTRUCTION BEGINS.
6. THE CONTRACTOR SHOULD CHECK THE PLOT AND SCHOOL BUILDING SERVICES CONNECTION POINTS, IN PARTICULAR FOR THE RAINWATER HARVESTING TANKS BEFORE INSTALLATION.
7. THE CONTRACTOR SHOULD REFER TO ALL PROTOTYPES DOCUMENTS PROVIDED BY LCEC THAT MUST BE READ IN COORDINATION WITH THE ACRHITECTURAL DRAWINGS.

PROJECT MAIN PARTICIPANTS

german cooperation
DEUTSCHE ZUSAMMENARBEIT

giz Deutsche Gesellschaft für Internationale Zusammenarbeit (GIZ) GmbH

الجمهورية اللبنانية
وزارة التربية والتعليم العالي

CLIENT

LCEC
LEBANESE CENTER FOR ENERGY CONSERVATION
المركز اللبناني لدعم الطاقة
efficient resources, sustainable achievements

CONSULTANT

INTERNATIONAL CONSULTANT - ICON

ICON INTERNATIONAL CONSULTANT
Beirut- Lebanon
P.O.BOX701, Antelias
Tel : + 961 4 404304 / 5
Fax : + 961 4 414250
e-mail: info@icon-py.com
Website: www.icon-py.com

Rev #	Last revision titles	Drawn by: dd/mm/yy	Verified by: dd/mm/yy	Approved by: dd/mm/yy	Status
01	Final Design	R.R 31/7/23	R.B 31/7/23	P.Y 31/7/23	X
00	Final Design	R.R 16/6/23	R.B 16/6/23	P.Y 18/6/23	X

Issuer internal approval circuit and revision history

Project ------

SUFA AT PUBLIC SCHOOLS IN LEBANON

Project Work Package

Issuer

ICON

Phase / Nature FD

FINAL DESIGN

Primary Technical Discipline A--

ARCHITECTURE

Drawing Number and Title A-201

BAAKLIN MIXED INTERMEDIATE PUBLIC SCHOOL SHOUF - OUTDOOR CLASSROOM PROTOTYPE 1 - DETAILS

ARCHITECTURE

FINISH LEVELS -------

Revision Number 01

Review Cycle :

Folio	Format	Scale
	A1	1/20

File spec : ----------

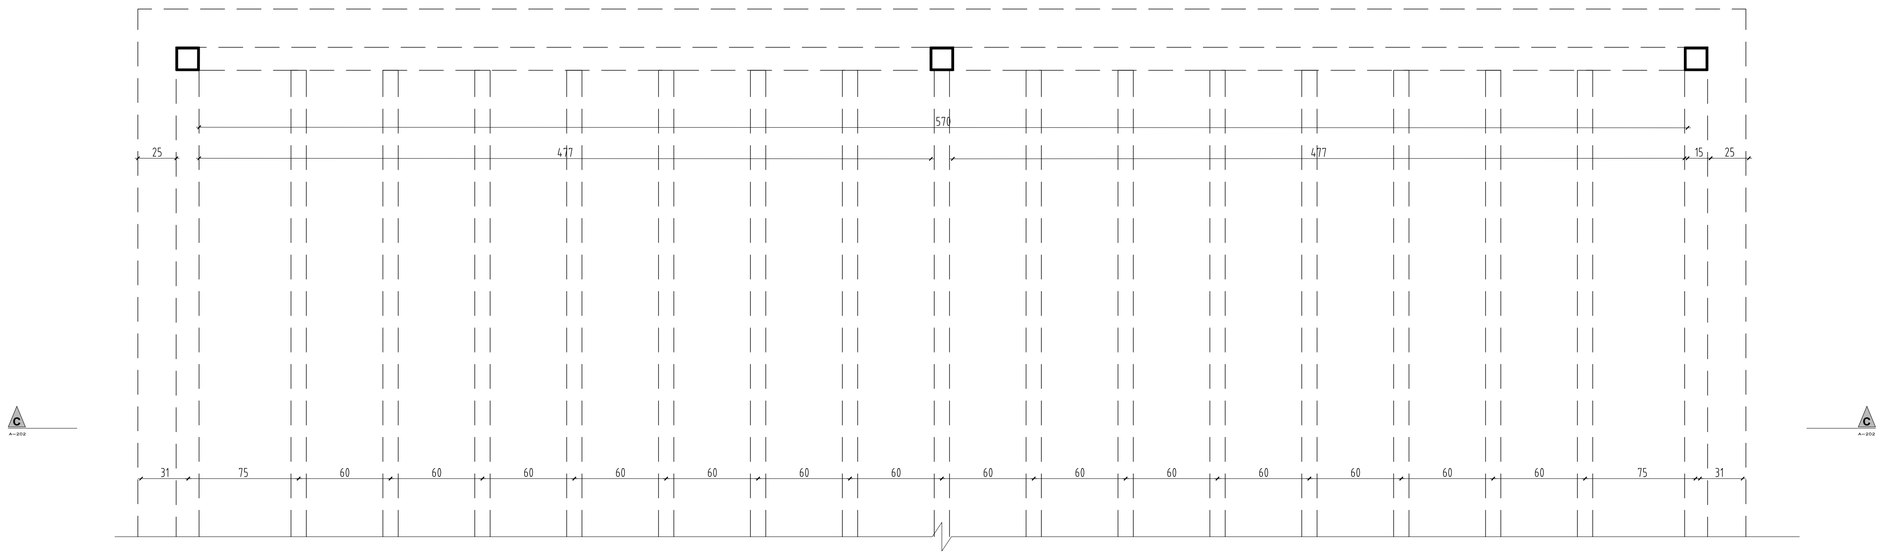

01 A-202 PLAN SCALE: 1/120

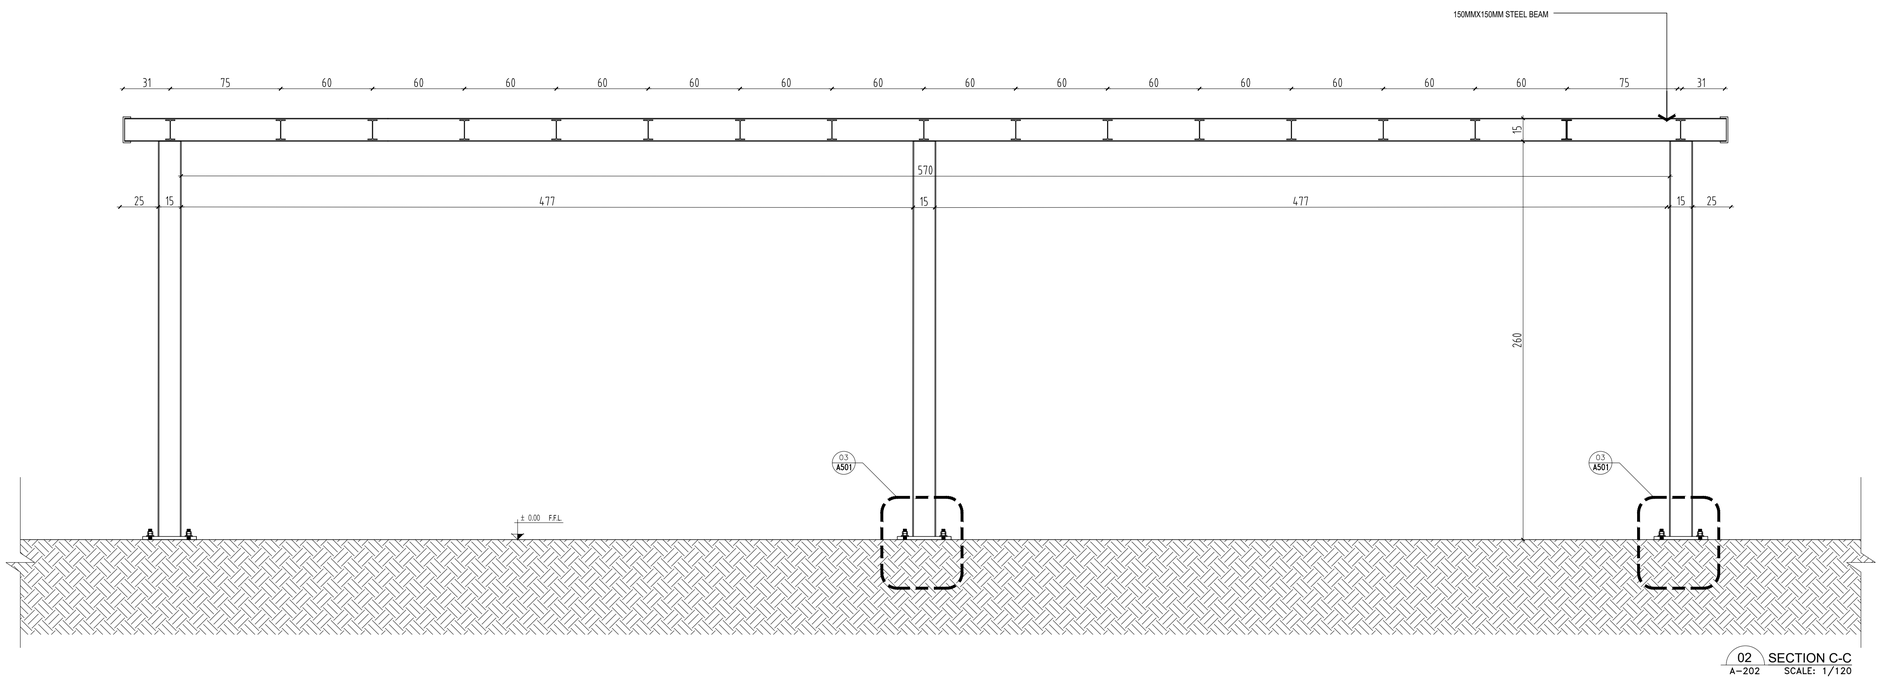

02 A-202 SECTION C-C SCALE: 1/120

GENERAL NOTES

1. UNLESS OTHERWISE NOTED, ALL DIMENSIONS ARE IN CENTIMETERS.
2. DO NOT SCALE DRAWINGS, DIMENSIONS GIVEN SHALL GOVERN.
3. CONTRACTOR SHALL SUBMIT SHOP DRAWINGS AND SAMPLES OF ALL MATERIALS & COLORS FOR CLIENT & ARCHITECT APPROVAL.
4. ALL DIMENSIONS MUST BE VERIFIED BY CONTRACTORS BEFORE PREPARATION OF SHOP DRAWINGS.
5. THE ARCHITECT MUST BE INFORMED ABOUT CONTRADICTION OF ANY KIND BEFORE CONSTRUCTION BEGINS.
6. THE CONTRACTOR SHOULD CHECK THE PLOT AND SCHOOL BUILDING SERVICES CONNECTION POINTS, IN PARTICULAR FOR THE RAINWATER HARVESTING TANKS BEFORE INSTALLATION.
7. THE CONTRACTOR SHOULD REFER TO ALL PROTOTYPES DOCUMENTS PROVIDED BY LCEC THAT MUST BE READ IN COORDINATION WITH THE ACRHITECTURAL DRAWINGS.

PROJECT MAIN PARTICIPANTS

german cooperation
DEUTSCHE ZUSAMMENARBEIT

giz Deutsche Gesellschaft für Internationale Zusammenarbeit (GIZ) GmbH

الجمهورية اللبنانية
وزارة التربية والتعليم العالي

CLIENT

LCEC
LEBANESE CENTER FOR ENERGY CONSERVATION
المركز اللبناني لدعم الطاقة
efficient resources, sustainable achievements

CONSULTANT

INTERNATIONAL CONSULTANT - ICON

ICON INTERNATIONAL CONSULTANT
Beirut- Lebanon
P.O.BOX701, Antelias
Tel : + 961 4 404304 / 5
Fax : + 961 4 414250
e-mail: info@icon-py.com
Website: www.icon-py.com

01	Final Design	R.R 31/7/23	R.B 31/7/23	P.Y 31/7/23	X
00	Final Design	R.R 16/6/23	R.B 16/6/23	P.Y 18/6/23	X
Rev #	Last revision titles	Drawn by: dd/mm/yy	Verified by: dd/mm/yy	Approved by: dd/mm/yy	Status

Issuer internal approval circuit and revision history

Project ------

SUFA AT PUBLIC SCHOOLS IN LEBANON

Project Work Package

Issuer

ICON

Phase / Nature FD

FINAL DESIGN

Primary Technical Discipline A--

ARCHITECTURE

Drawing Number and Title A-202

BAAKLIN MIXED INTERMEDIATE PUBLIC SCHOOL SHOUF CANOPY DETAILS

ARCHITECTURE

FINISH LEVELS -------

Revision Number 01

Review Cycle :

Folio	Format	Scale
	A1	1/20

File spec : ----------

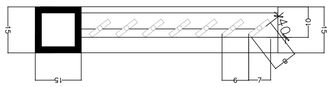

DETAIL 01-A-501
SCALE 1/10

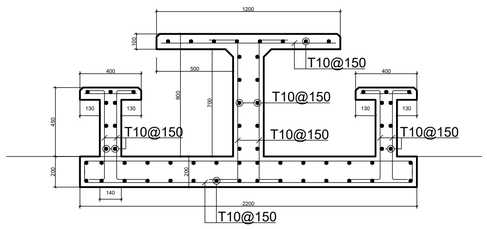

WELL COMPACTED FILL

LEARNING STATION - FIX CONCRETE DETAIL 02-A-501
SCALE 1/20

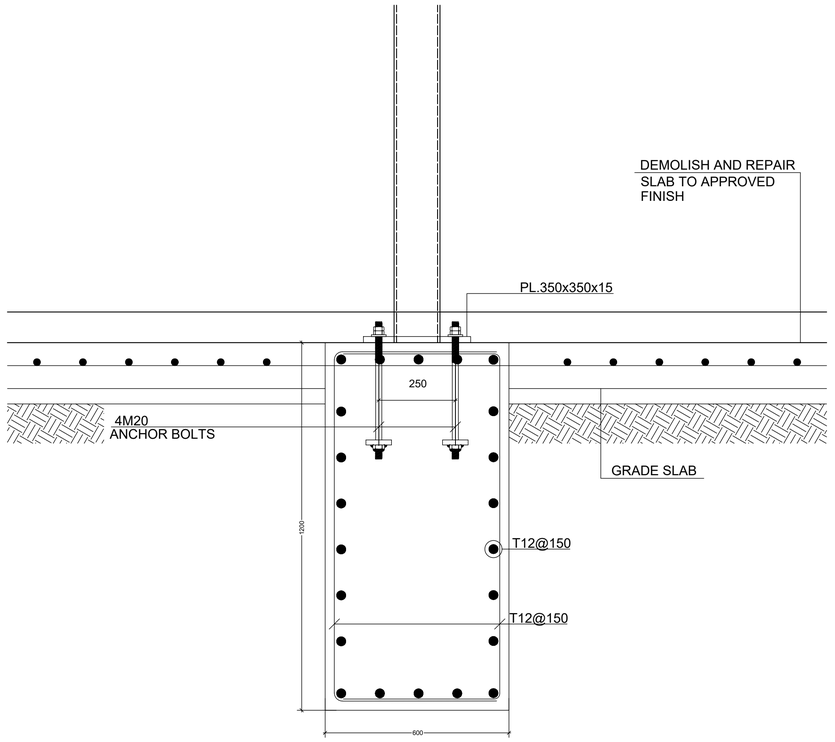

DETAIL 03-A-501
SCALE 1/10

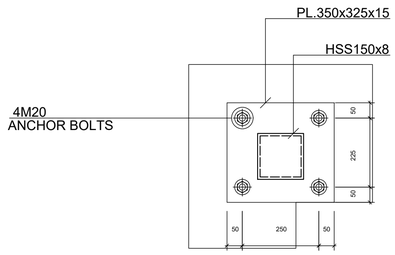

BASE PLATE 04-A-501
SCALE 1/10

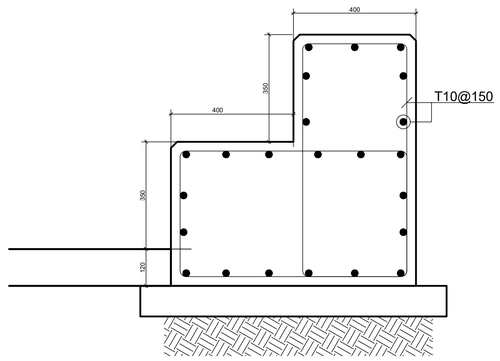

AMPHITHEATER BENCH 05-A-501
SCALE 1/10

GENERAL NOTES

1. UNLESS OTHERWISE NOTED, ALL DIMENSIONS ARE IN CENTIMETERS.
2. DO NOT SCALE DRAWINGS, DIMENSIONS GIVEN SHALL GOVERN.
3. CONTRACTOR SHALL SUBMIT SHOP DRAWINGS AND SAMPLES OF ALL MATERIALS & COLORS FOR CLIENT & ARCHITECT APPROVAL.
4. ALL DIMENSIONS MUST BE VERIFIED BY CONTRACTORS BEFORE PREPARATION OF SHOP DRAWINGS.
5. THE ARCHITECT MUST BE INFORMED ABOUT CONTRADICTION OF ANY KIND BEFORE CONSTRUCTION BEGINS.
6. THE CONTRACTOR SHOULD CHECK THE PLOT AND SCHOOL BUILDING SERVICES CONNECTION POINTS, IN PARTICULAR FOR THE RAINWATER HARVESTING TANKS BEFORE INSTALLATION.
7. THE CONTRACTOR SHOULD REFER TO ALL PROTOTYPES DOCUMENTS PROVIDED BY LCEC THAT MUST BE READ IN COORDINATION WITH THE ACRHITECTURAL DRAWINGS.

PROJECT MAIN PARTICIPANTS

german cooperation
DEUTSCHE ZUSAMMENARBEIT

giz Deutsche Gesellschaft für Internationale Zusammenarbeit (GIZ) GmbH

الجمهورية اللبنانية
وزارة التربية والتعليم العالي

CLIENT

LCEC
LEBANESE CENTER FOR ENERGY CONSERVATION
المركز اللبناني لحفظ الطاقة
efficient resources, sustainable achievements

CONSULTANT

INTERNATIONAL CONSULTANT - ICON

ICON INTERNATIONAL CONSULTANT
Beirut- Lebanon
P.O.BOX701, Antelias
Tel : + 961 4 404304 / 5
Fax : + 961 4 414250
e-mail: info@icon-py.com
Website: www.icon-py.com

Rev #	Last revision titles	Drawn by: dd/mm/yy	Verified by: dd/mm/yy	Approved by: dd/mm/yy	Status
01	Final Design	R.R 31/7/23	R.B 31/7/23	P.Y 31/7/23	X
00	Final Design	R.R 16/6/23	R.B 16/6/23	P.Y 18/6/23	X

Issuer internal approval circuit and revision history

Project
SUFA AT PUBLIC SCHOOLS IN LEBANON

Project Work Package

Issuer
ICON

Phase / Nature
FINAL DESIGN — FD

Primary Technical Discipline
ARCHITECTURE — A--

Drawing Number and Title
A-501
MISCELLANEOUS DETAILS

ARCHITECTURE
FINISH LEVELS -------

Revision Number 01

Review Cycle :

Folio	Format	Scale
	A1	AS SHOWN

File spec : ----------

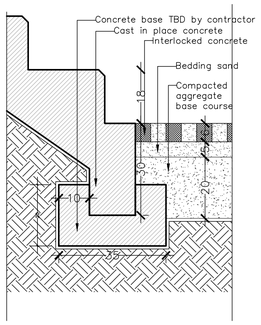

DETAIL 01-A-502

SCALE 1/10

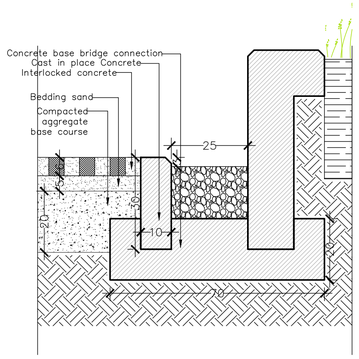

DETAIL 02-A-502

SCALE 1/10

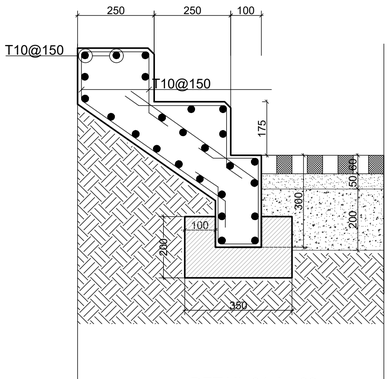

DETAIL 01-A-502

SCALE 1/10

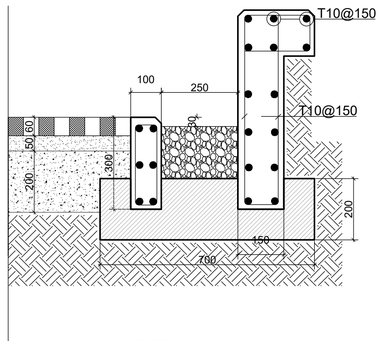

DETAIL 02-A-502

SCALE 1/10

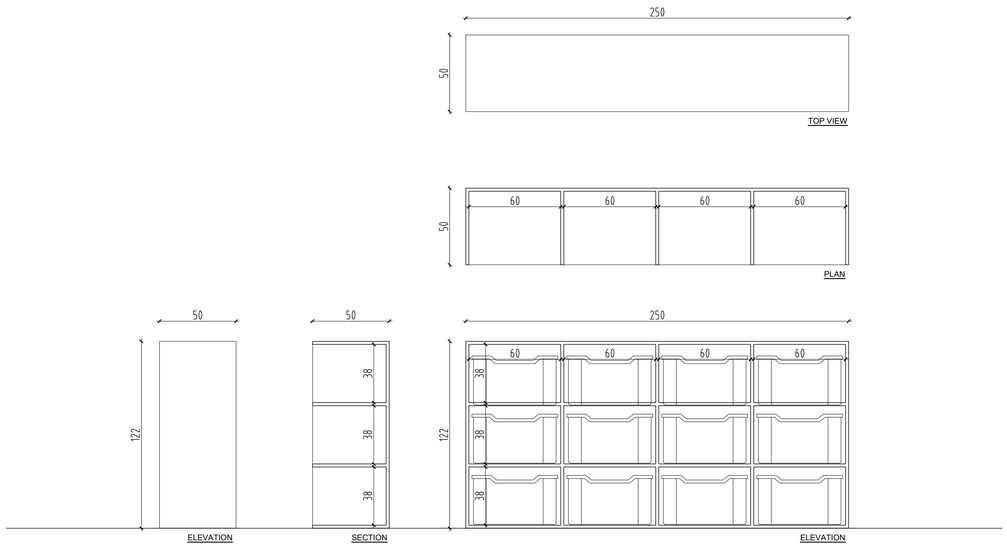

WOODEN UNIT FOR ACTIVITIES STORAGE

SCALE 1/20

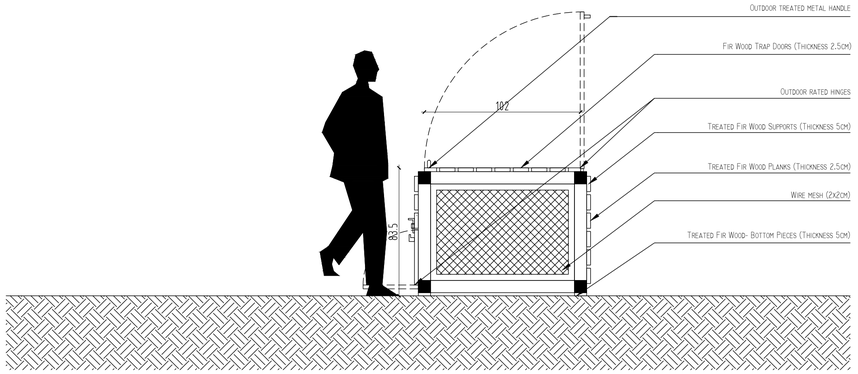

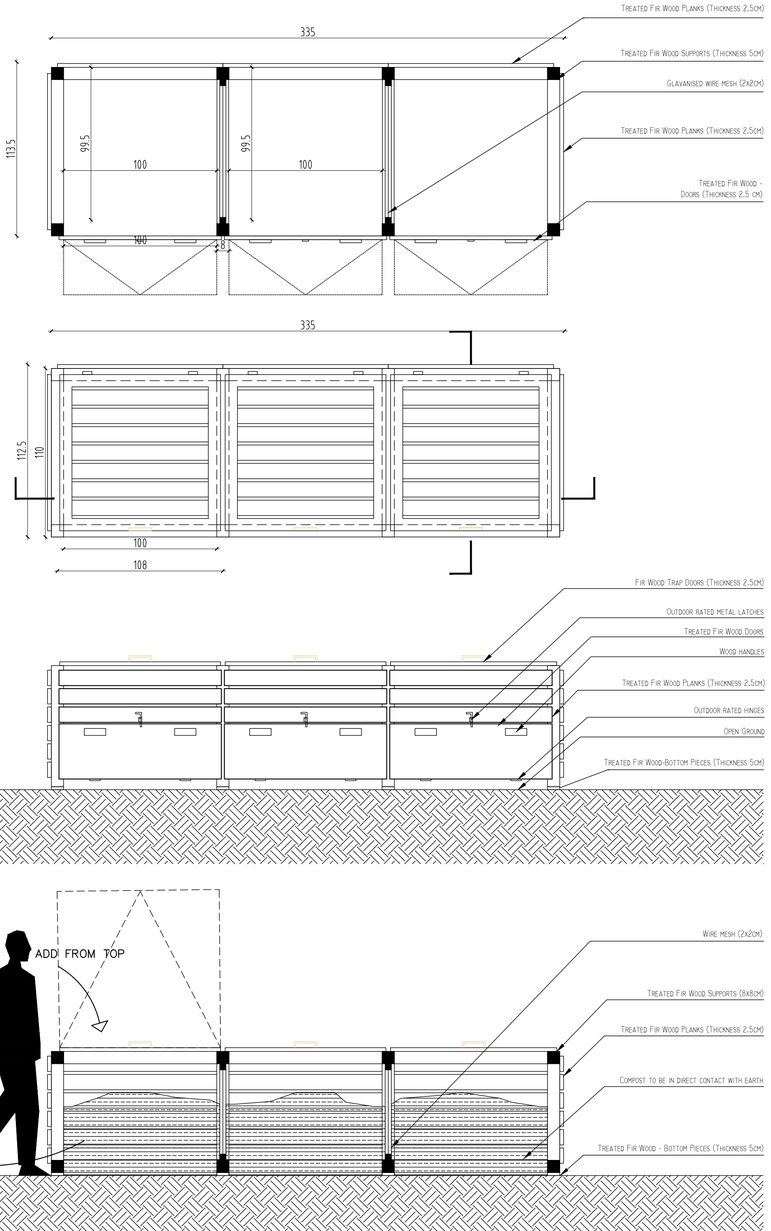

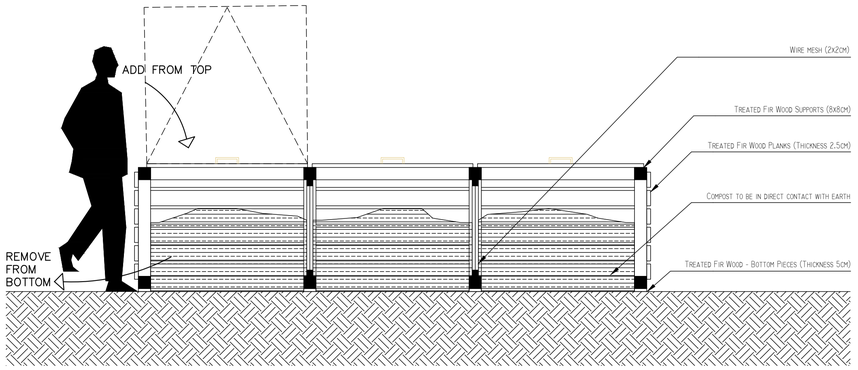

COMPOST STATION PROTOTYPE 03-A-502

SCALE 1/20

GENERAL NOTES

1. UNLESS OTHERWISE NOTED, ALL DIMENSIONS ARE IN CENTIMETERS.
2. DO NOT SCALE DRAWINGS, DIMENSIONS GIVEN SHALL GOVERN.
3. CONTRACTOR SHALL SUBMIT SHOP DRAWINGS AND SAMPLES OF ALL MATERIALS & COLORS FOR CLIENT & ARCHITECT APPROVAL.
4. ALL DIMENSIONS MUST BE VERIFIED BY CONTRACTORS BEFORE PREPARATION OF SHOP DRAWINGS.
5. THE ARCHITECT MUST BE INFORMED ABOUT CONTRADICTION OF ANY KIND BEFORE CONSTRUCTION BEGINS.
6. THE CONTRACTOR SHOULD CHECK THE PLOT AND SCHOOL BUILDING SERVICES CONNECTION POINTS, IN PARTICULAR FOR THE RAINWATER HARVESTING TANKS BEFORE INSTALLATION.
7. THE CONTRACTOR SHOULD REFER TO ALL PROTOTYPES DOCUMENTS PROVIDED BY LCEC THAT MUST BE READ IN COORDINATION WITH THE ACRHITECTURAL DRAWINGS.

PROJECT MAIN PARTICIPANTS

german cooperation
DEUTSCHE ZUSAMMENARBEIT

giz Deutsche Gesellschaft für Internationale Zusammenarbeit (GIZ) GmbH

الجمهورية اللبنانية
وزارة التربية والتعليم العالي

CLIENT

LCEC
LEBANESE CENTER FOR ENERGY CONSERVATION
المركز اللبناني لدعم الطاقة
efficient resources, sustainable achievements

CONSULTANT

INTERNATIONAL CONSULTANT - ICON

ICON INTERNATIONAL CONSULTANT
Beirut- Lebanon
P.O.BOX701, Antelias
Tel : + 961 4 404304 / 5
Fax : + 961 4 414250
e-mail: info@icon-py.com
Website: www.icon-py.com

Rev #	Last revision titles	Drawn by: dd/mm/yy	Verified by: dd/mm/yy	Approved by: dd/mm/yy	Status
01	Final Design	R.R 31/7/23	R.B 31/7/23	P.Y 31/7/23	X
00	Final Design	R.R 16/6/23	R.B 16/6/23	P.Y 18/6/23	X

Issuer internal approval circuit and revision history

Project
SUFA AT PUBLIC SCHOOLS IN LEBANON

Project Work Package

Issuer
ICON

Phase / Nature: FD
FINAL DESIGN

Primary Technical Discipline: A – –
ARCHITECTURE

Drawing Number and Title: A-502
MISCELLANEOUS DETAILS

ARCHITECTURE
FINISH LEVELS ------

Revision Number: 01

Review Cycle :

Folio	Format	Scale
	A1	AS SHOWN

File spec : ----------

RAL 9016

Ral 9005

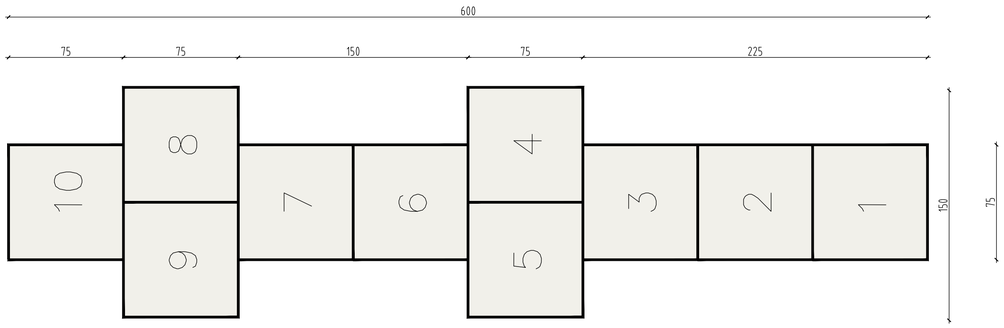

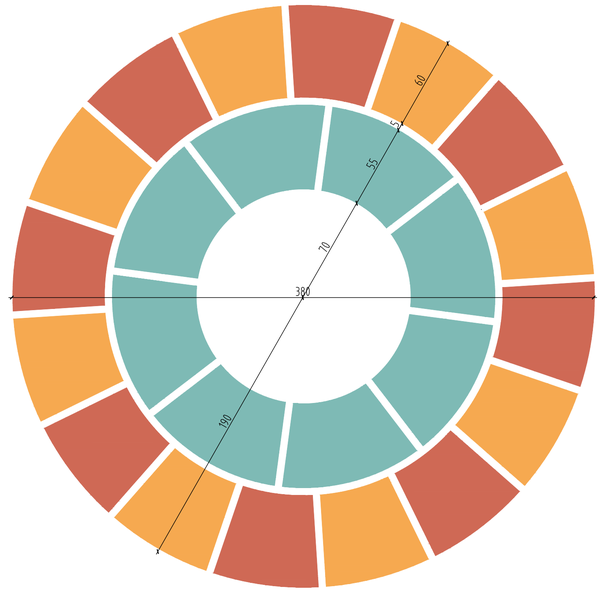

RAL6027

RAL 3022

RAL 6016

RAL 1017

RAL 4005

RAL 3022

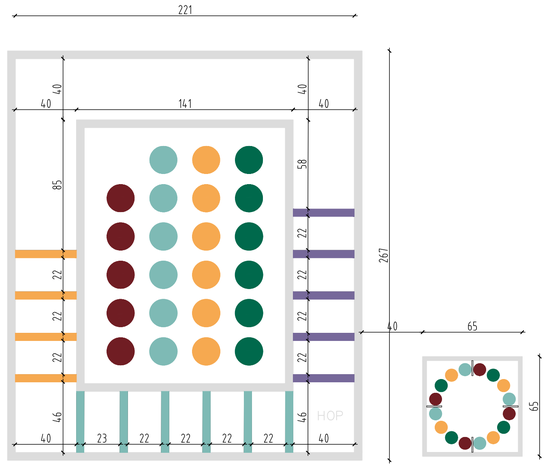

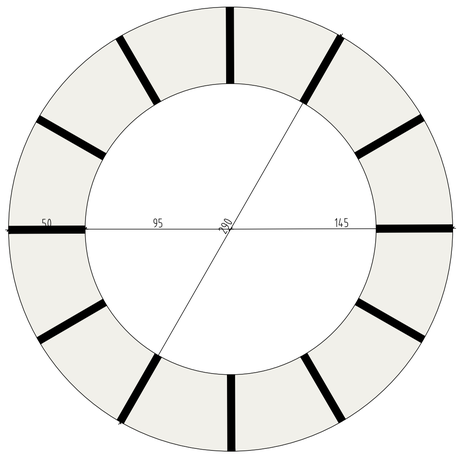

GENERAL NOTES

1. UNLESS OTHERWISE NOTED, ALL DIMENSIONS ARE IN CENTIMETERS.
2. DO NOT SCALE DRAWINGS, DIMENSIONS GIVEN SHALL GOVERN.
3. CONTRACTOR SHALL SUBMIT SHOP DRAWINGS AND SAMPLES OF ALL MATERIALS & COLORS FOR CLIENT & ARCHITECT APPROVAL.
4. ALL DIMENSIONS MUST BE VERIFIED BY CONTRACTORS BEFORE PREPARATION OF SHOP DRAWINGS.
5. THE ARCHITECT MUST BE INFORMED ABOUT CONTRADICTION OF ANY KIND BEFORE CONSTRUCTION BEGINS.
6. THE CONTRACTOR SHOULD CHECK THE PLOT AND SCHOOL BUILDING SERVICES CONNECTION POINTS, IN PARTICULAR FOR THE RAINWATER HARVESTING TANKS BEFORE INSTALLATION.
7. THE CONTRACTOR SHOULD REFER TO ALL PROTOTYPES DOCUMENTS PROVIDED BY LCEC THAT MUST BE READ IN COORDINATION WITH THE ACRHITECTURAL DRAWINGS.

PROJECT MAIN PARTICIPANTS

german cooperation
DEUTSCHE ZUSAMMENARBEIT

giz Deutsche Gesellschaft für Internationale Zusammenarbeit (GIZ) GmbH

الجمهورية اللبنانية
وزارة التربية والتعليم العالي

CLIENT

LCEC
LEBANESE CENTER FOR ENERGY CONSERVATION
المركز اللبناني لدعم الطاقة
efficient resources, sustainable achievements

CONSULTANT

INTERNATIONAL CONSULTANT - ICON

ICON INTERNATIONAL CONSULTANT
Beirut- Lebanon
P.O.BOX701, Antelias
Tel : + 961 4 404304 / 5
Fax : + 961 4 414250
e-mail: info@icon-py.com
Website: www.icon-py.com

Rev #	Last revision titles	Drawn by: dd/mm/yy	Verified by: dd/mm/yy	Approved by: dd/mm/yy	Status
01	Final Design	R.R 31/7/23	R.B 31/7/23	P.Y 31/7/23	X
00	Final Design	R.R 16/6/23	R.B 16/6/23	P.Y 18/6/23	X

Issuer internal approval circuit and revision history

Project ------

SUFA AT PUBLIC SCHOOLS IN LEBANON

Project Work Package

Issuer

ICON

Phase / Nature: FD

FINAL DESIGN

Primary Technical Discipline: A – –

ARCHITECTURE

Drawing Number and Title: A-503

PLAYGROUND MARKINGS PROTOTYPES

ARCHITECTURE

FINISH LEVELS -------

Revision Number: 01

Review Cycle :

Folio	Format	Scale
	A1	1/20

File spec : ----------

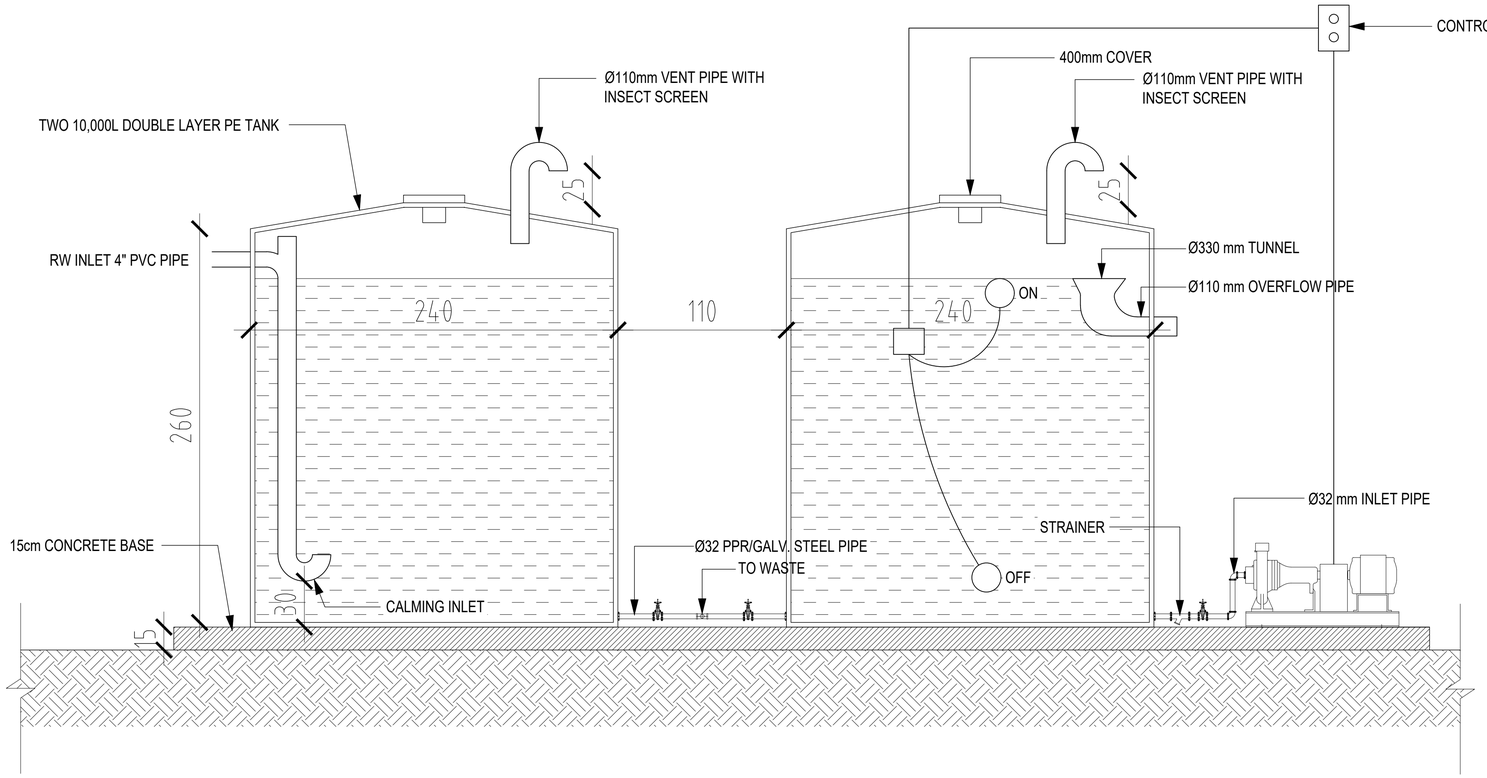

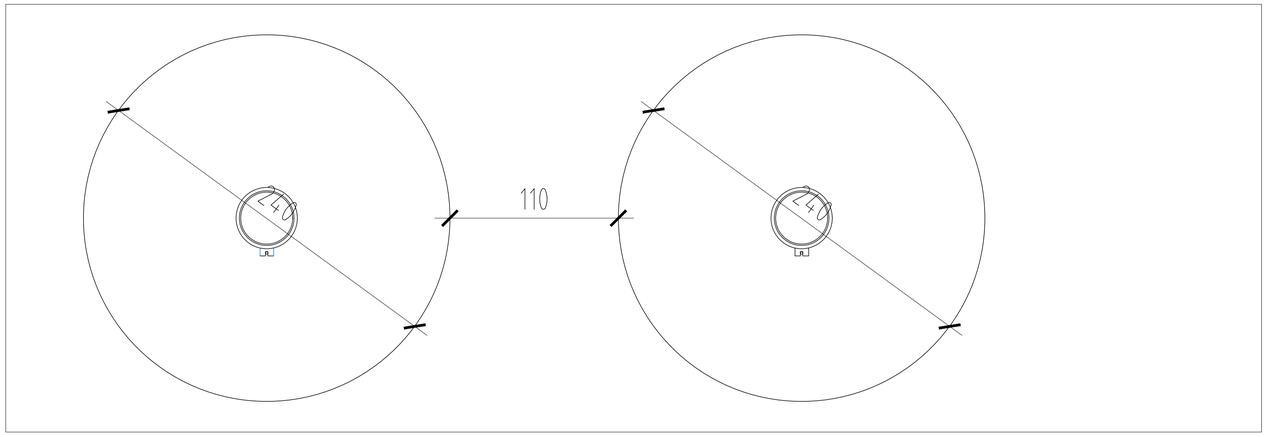

GENERAL NOTES

1. UNLESS OTHERWISE NOTED, ALL DIMENSIONS ARE IN CENTIMETERS.
2. DO NOT SCALE DRAWINGS, DIMENSIONS GIVEN SHALL GOVERN.
3. CONTRACTOR SHALL SUBMIT SHOP DRAWINGS AND SAMPLES OF ALL MATERIALS & COLORS FOR CLIENT & ARCHITECT APPROVAL.
4. ALL DIMENSIONS MUST BE VERIFIED BY CONTRACTORS BEFORE PREPARATION OF SHOP DRAWINGS.
5. THE ARCHITECT MUST BE INFORMED ABOUT CONTRADICTION OF ANY KIND BEFORE CONSTRUCTION BEGINS.
6. THE CONTRACTOR SHOULD CHECK THE PLOT AND SCHOOL BUILDING SERVICES CONNECTION POINTS, IN PARTICULAR FOR THE RAINWATER HARVESTING TANKS BEFORE INSTALLATION.
7. THE CONTRACTOR SHOULD REFER TO ALL PROTOTYPES DOCUMENTS PROVIDED BY LCEC THAT MUST BE READ IN COORDINATION WITH THE ACRHITECTURAL DRAWINGS.

PROJECT MAIN PARTICIPANTS

german cooperation
DEUTSCHE ZUSAMMENARBEIT

giz Deutsche Gesellschaft für Internationale Zusammenarbeit (GIZ) GmbH

الجمهورية اللبنانية
وزارة التربية والتعليم العالي

CLIENT

LCEC
LEBANESE CENTER FOR ENERGY CONSERVATION
efficient resources, sustainable achievements

CONSULTANT

INTERNATIONAL CONSULTANT - ICON

ICON INTERNATIONAL CONSULTANT
Beirut- Lebanon
P.O.BOX701, Antelias
Tel : + 961 4 404304 / 5
Fax : + 961 4 414250
e-mail: info@icon-py.com
Website: www.icon-py.com

Rev #	Last revision titles	Drawn by: dd/mm/yy	Verified by: dd/mm/yy	Approved by: dd/mm/yy	Status
01	Final Design	R.R 31/7/23	R.B 31/7/23	P.Y 31/7/23	X
00	Final Design	R.R 16/6/23	R.B 16/6/23	P.Y 18/6/23	X

Issuer internal approval circuit and revision history

Project ------
SUFA AT PUBLIC SCHOOLS IN LEBANON
Project Work Package

Issuer
ICON
Phase / Nature FD
FINAL DESIGN
Primary Technical Discipline A--
ARCHITECTURE
Drawing Number and Title A-504
RAINWATER HARVESTING TANKS
ARCHITECTURE
FINISH LEVELS -------
Revision Number 01

Review Cycle :

Folio	Format	Scale
	A1	1/20

File spec : ----------